FORM 51 10M 8-47

KANSAS


Phillips

Section 22 Township 5 Range 20W

Well No. 9 Graham

Company Skelly

Hansen

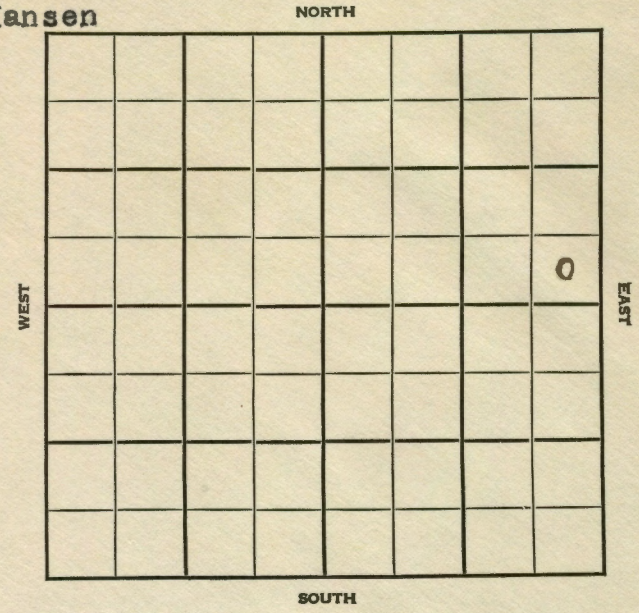

8

5M 9-47 PETROL

KANSAS

Phillips

Sec. 22 Twp. 5 R. 20W

Well No. #9 Graham Farm

Skelly Oil Co. Company

Hansen


____ Ft. from N. Line

330 Ft. from S. Line

330 Ft. from E. Line

____ Ft. from W. Line

SE NE

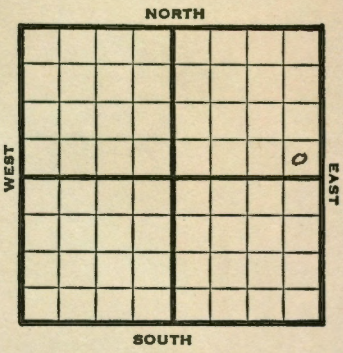

1947	Elev. 2160' REPORT
11/5	Location
11/12	"
11/19	18" @ 276' Drlg. 1315'
11/25	Lansing 3255' TD 3326' 7" @ 3306' RUST
12/6	"
12/10	"
12/17	"
12/30	"
1948	
1/7	TD 3365' - 3000 acid Pump 221 bbls. oil 24 hrs.
1/14	Lansing 3255' 7" @ 3306' Perf. 4000 acid Pump 375 Pot 28.0 Gr. TD 3365' Compl.

COMPLETED

Form 26 200 Bks. 10-46 Petrol

Kansas

Hansen Pool

Map No. 133 Sec. 22 Twp. 5 R. 20W

Well No. 9 Graham

Skelly Company


COMPLETE

Contractor

SE NE

E1,2160

SECTION PLAT

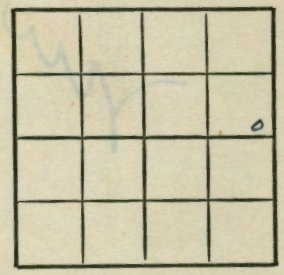

____ Ft. from N. Line

330 Ft. from S. Line

330 Ft. from E. Line

____ Ft. from W. Line

Phillips County

Location ____

Rig up ____

Drilling and Remarks:

Loaned 8200'.

7" @ 8806

Perf.

Associated

Pump 325 Bbl

25-64

RECORD

Cased ____ in., ____ ft.

Sand ____

Gas ____

Oil ✓

Total Depth 8356

PRODUCTION

1st 24 hrs. Nat. ____

1st 24 hrs. after shot ____

Gas ____ Cu. Ft.

Dry Hole ____

Abandoned ____

Date

JAN 14 1948 19

S. J. LEWIS Scout

Form 26 200 Bks. 10-46 Petrol

Kansas

Hansen Pool

Map No. ____ Sec. 22 Twp. 5 R. 20W

Well No. 9 Graham


Skelly Company

FIRST REPORT

Contractor

SE NE

SECTION PLAT

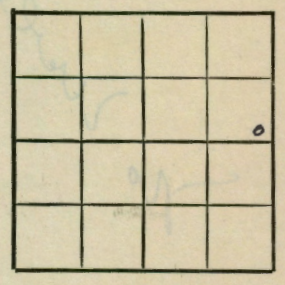

____ Ft. from N. Line

330 Ft. from S. Line

330 Ft. from E. Line

____ Ft. from W. Line

Phillips County

Location X

Rig up ____

Drilling and Remarks:

RECORD

Cased ____ in., ____ ft.

Sand ____

Gas ____

Oil ____

Total Depth ____

PRODUCTION

1st 24 hrs. Nat. ____

1st 24 hrs. after shot ____

Gas ____ Cu. Ft.

Dry Hole ____

Abandoned ____

Date

NOV 5 1947 19

S. J. LEWIS Scout