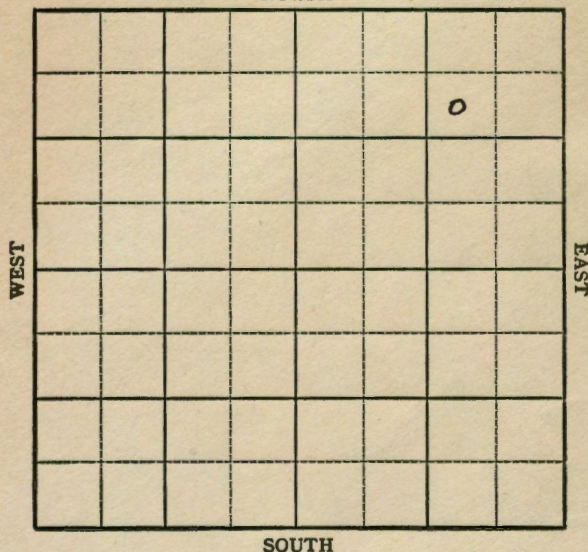


O. W. D. D KANSAS

Phillips

Section 22 Township 5 Range 20WWell No. 11 GrahamCompany SkellyHansen Pool
NORTH

5M 10-48 PETROL

KANSAS

Phillips

O. W. D. D

Sec. 22 Twp. 5 R. 20WWell No. #11 Graham FarmSkelly Company

Hansen


990' Ft. from N. Line

Ft. from S. Line

990' Ft. from E. Line

Ft. from W. Line

SW NE NE

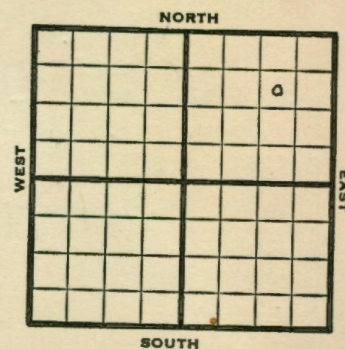1948 Elev 2143' REPORT

11/10	Location
11/16	"
11/23	8" @ 295'
11/30	Lansing 2234
	Arbuckle 3511-18'
	TD 3518'
	5" @ 3512'
12/8	"
12/14	"
12/22	"
12/29	"
1/5	24 shots @ 3350'-52'
	72 shots @ 3292-98'
	1400 acid swb 12 bbls oil and
	24 wtr in 7 hrs
1/12	PB 3278. 170 sw to 3258-72-
	3750 acid sw & oil - 3 hrs
1/19	77 shots 3232-40 750 acid
	Swb 24 bbls oil / 29 W 10 hrs.
1/26	Squeez Perf 3232-40
2/2	"
2/9	94 shots 3305-15
	500 acid
	Pump 130 bbls oil / 169 W 16 hrs.
2/16	"
2/23	"
3/3	"

OVER

1949

3/9

TD 3518'

Lans 3234'

Arb. 3511'

5" @ 3512'

Perf Lans.

4200 acid

Pump 87 Oil / 162W Pot

29° Gr.

Comp

COMPLETED

1952

O.W.D.D

3/19

Arb. 3510-18 OTD

5" @ 3512 DD 3523 1 boph

DD 3536 1 1/4 boph 2 boph

5 hr. HYDRO

Comp. 116 bopd 5% wtr.

FIRST REPORT

+

COMPLETED

O.W.D.D

Map No. 133 Sec. 22 Twp. 5 R. 20WWell No. 11 Graham

Skelly

Company

COMPLETE

Contractor

SW NE NE

SECTION PLAT

990 Ft. from N. Line

Ft. from S. Line

990 Ft. from E. Line

Ft. from W. Line

Phillips County

Location

RECORD

Cased in. ft.

Sand

Gas

Oil

Total Depth 3515

PRODUCTION

1st 24 hrs. Nat.

1st 24 hrs. after shot

Gas Cu. Ft.

Dry Hole

Abandoned

Date

MAR 9 1949

19

S. J. LEWIS

Scout

Map No. Sec. 22 Twp. 5 R. 20WWell No. 11 Graham

Skelly

Company

FIRST REPORT

Contractor

SW NE NE

SECTION PLAT

990 Ft. from N. Line

Ft. from S. Line

990 Ft. from E. Line

Ft. from W. Line

Phillips County

Location X

RECORD

Cased in. ft.

Sand

Gas

Oil

Total Depth

PRODUCTION

1st 24 hrs. Nat.

1st 24 hrs. after shot

Gas Cu. Ft.

Dry Hole

Abandoned

Date

NOV 10 1948

19

S. J. LEWIS

Scout

