


KANSAS

Phillips county

Section 23 Township 5 Range 20-W
 Well No. #2, Brown "B"
 Company Cities Service Oil Company

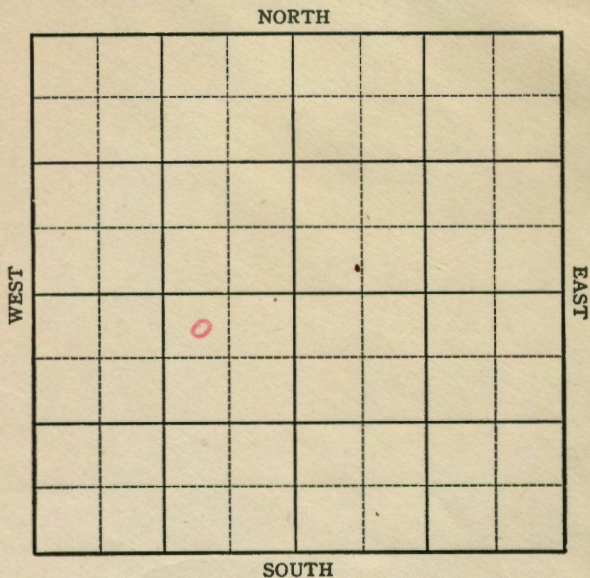

11


KANSAS

Phillips

Sec. 23 Twp. 5 R. 20W
 Well No. 2 Brown "B" Farm
 Cities Service Company

Hansen Pool

330 Ft. from N. Line
 Ft. from S. Line
990 Ft. from E. Line
 Ft. from W. Line

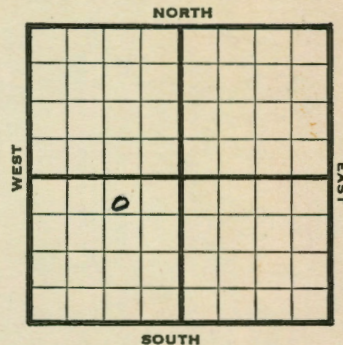

NW NE SW

1946

Elev. 2176

REPORT

11/13 Derrick
 11/20 8" @ 204'
 Drlg 2345'
 11/27 Lans 3290'
 Arb 3545'
 TD 3580'
 5" @ 3579', RUST
 12/1 " "
 12/10 TD 3628'
 775' W plus 225' oil
 12/17 PB 3575'
 59 shots 3543-55
 72 shot 3562-75, 1000' oil
 13 hrs, 1000 acid
 1947
 1/4 PB 3575 59 shots 3543-5572
 shot 3562-75
 1000' oil 13 hrs, 1000 acid
 1/8 " " "
 1/15 " " "
 1/21 " " "

OVER

1/29 TD 3628'

Arb 3545

5" @ 3579

5"

Perf

1000 Acid

Pump 43 oil to 8% W

Pot

33 Gr

COMPLETED

Map No. 133 Sec. 23 Twp. 5 R. 20WWell No. 2 Brown "B"

Cities Service

Company

COMPLETE

Contractor

NW NE SW

E12176
SECTION PLAT330 Ft. from N. Line

Ft. from S. Line

990 Ft. from E. Line

Ft. from W. Line

Phillips County

Location

Rig up

Drilling and Remarks:

Cut 3545523079Prof.1000' oilPump 40' oil + 8' gasOK23 9 47

RECORD

Cased in, ft.

Sand

Gas

Oil

Total Depth 3625

PRODUCTION

1st 24 hrs. Nat.

1st 24 hrs. after shot

Gas Cu. Ft.

Dry Hole

Abandoned

Date

JAN 29 1947 19S. J. LEWIS

Scout

Map No. 133 Sec. 23 Twp. 5 R. 20WWell No. 2 Brown "B"

Cities Service

Company

FIRST REPORT

Contractor

NW NE SW

SECTION PLAT

330 Ft. from N. Line

Ft. from S. Line

990 Ft. from E. Line

Ft. from W. Line

Phillips County

Location

Rig up

Drilling and Remarks:

Derrick

RECORD

Cased in, ft.

Sand

Gas

Oil

Total Depth

PRODUCTION

1st 24 hrs. Nat.

1st 24 hrs. after shot

Gas Cu. Ft.

Dry Hole

Abandoned

Date

NOV 13 1946 19S. J. LEWIS

Scout