


KANSAS

Phillips

FORM 51 IOM 12-46 PETROL

Section 23 Township 5 Range 20WWell No. 3 Brown " B"Company Cities Service

NORTH

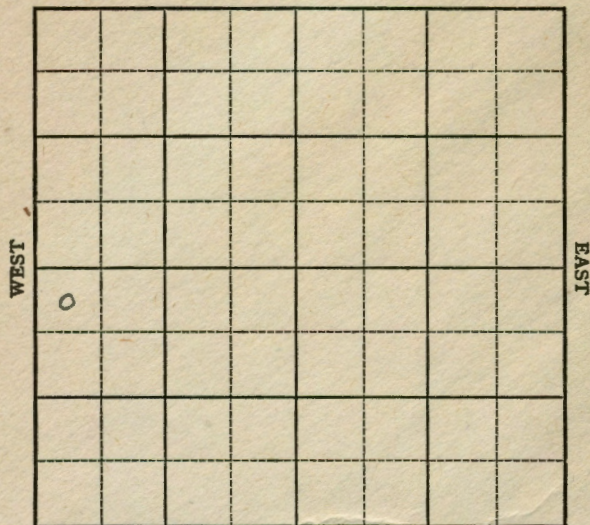

SOUTH

12

SM 12-46 PETROL

23

5

KANSAS

Phillips Cnty.

20W

Sec. _____ Twp. _____ R. _____

Well No. 3 Brown "B" Farm _____

Cities Service Company

Ray pool

330 Ft. from N. Line


_____ Ft. from S. Line

_____ Ft. from E. Line

330 Ft. from W. Line

NW SW

NORTH

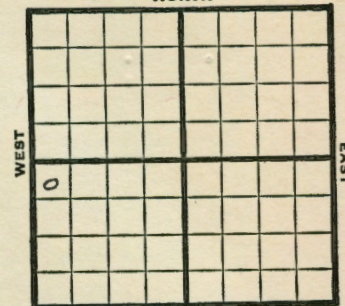

SOUTH

1947 **Elev. 2140'** REPORT

5/28 Derrick

6/3 RUR

6/10 8" @ 200
Drlg. 1900'6/17 **Lansing 3252'**
Arbuckle 3516
TD 3555
5" @ 3554'
Rust6/24 **SIM 3555-47'**
Lansing 3244'
Arbuckle 3508-
5" @ 3546'
98 shots 3320-42
36 " 3249-54
1537' oil 2 hrs.
Acid

OVER

7/2 Lans. 3244⁵
 Arb. 3508¹
 5" @ 3546¹
 Perf. Lans.
 3000 acid.
 Pump 427 Pot
 28.0 Gr.
 TD 3547¹

COMPLETED

