
KANSAS
FORM 51 5M PETROL

Phillips

Section 23 Township 5 Range 20-W

Well No. #2 Graham

Company Skelly

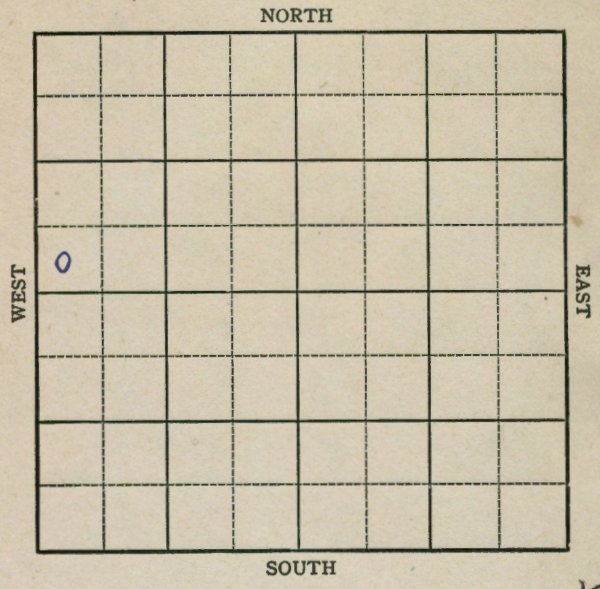

5


FORM 252-A
5M 9-43 GASS KANSAS

Phillips

Sec. 23 Twp. 5 R. 20-W

Well No. #2 Graham Farm

Skelly Company

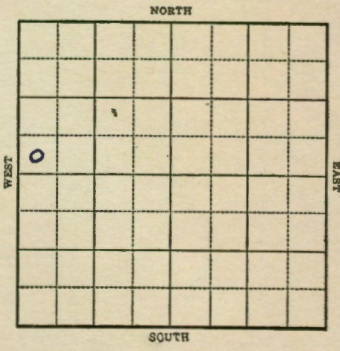

Ft. from N. Line

330 Ft. from S. Line

Ft. from E. Line

330 Ft. from W. Line

Elev. 2134

1943	REPORT
10/27	Rotary
11/3	8" @ 190' Drlg. 595'
11/10	Gorhan 3498 Sat Arb 3500 T.D. 3505 5" @ 3501 RUST
11/17	" "
11/24	Arb.3499 corrected. TD 3567 5" @ 3500' Shot 28 oil in 28 hrs
12/1	3000 acid
12/8	" "
12/15	5" @ 3499 Arb 3500 3000 acid Pump 284 Pet. T.D.. 3567 Gravity 35

COMPLETED

Form 26 200 Bks 5-42 Petrol Phillips

KANSAS

Map No. 33 Sec. 23 Twp. 5 R. 20W

Well No. 2 Graham

Skelly Company

COMPLETED Contractor

SW SW NW

SECTION PLAT

Ft. from N. Line

330 Ft. from S. Line

Ft. from E. Line

330 Ft. from W. Line

Rey Pool

Location

Rig up

Drilling and Remarks:

Ar #3495
5" @3506
2000 acid
Pump 25 BH.

35-2 Ga

RECORD

Cased in., ft.

Sand

Gas

Oil

Total Depth 3562

PRODUCTION

1st 24 hrs. Nat.

1st 24 hrs. after shot

Gas Cu. Ft.

Dry Hole

Abandoned

Date

DEC 15 1943 19 S. J. LEWIS Scout

Form 26 200 Bks 5-42 Petrol Phillips

KANSAS

Map No. 33 Sec. 23 Twp. 5 R. 20W

Well No. 2 Graham

Skelly Company

FIRST REPORT Contractor

SW SW NW

SECTION PLAT

Ft. from N. Line

330 Ft. from S. Line

Ft. from E. Line

330 Ft. from W. Line

Rey Pool

Location

Rig up

Drilling and Remarks:

Rotary

RECORD

Cased in., ft.

Sand

Gas

Oil

Total Depth

PRODUCTION

1st 24 hrs. Nat.

1st 24 hrs. after shot

Gas Cu. Ft.

Dry Hole

Abandoned

Date

OCT 27 1943 19 S. J. LEWIS Scout