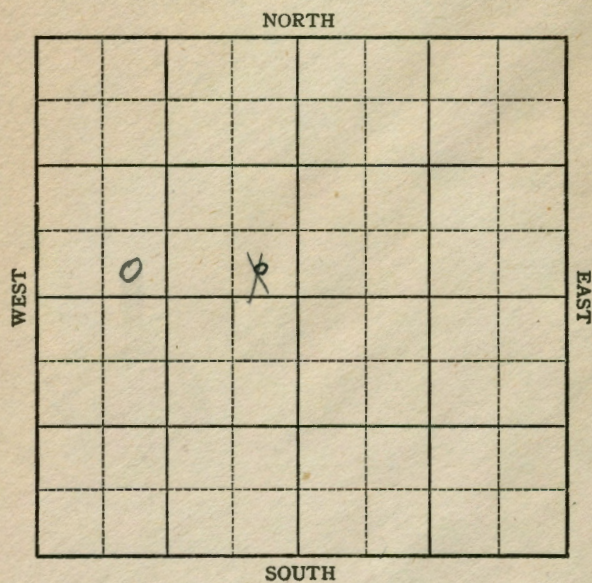


KANSAS

Phillips

Section 23 Township 5 Range 20WWell No. 7 GrahamCompany Skelly

KANSAS


Phillips

Sec. 23 Twp. 5-S R. 20-WWell No. #7 Graham FarmSkellyRay Pool Company

Ft. from N. Line

330 Ft. from S. Line

Ft. from E. Line

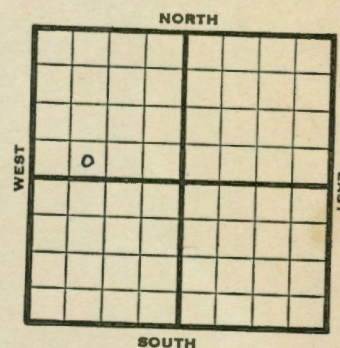990 Ft. from W. Line

SE SW NW

1947 Elev. 2168' REPORT

4/16 RUR

4/23 8" @ 255'
Drlg 2270'4/29 Lansing 3238'
TD 3315'
5" @ 3310'
RUST5/7 TD 3347'
Swb 38 bbls oil in 6 hrs5/13 30000 Acid
Pump 191 bbls oil in 11 hrs.5/21 Lans 3233'
5" @ 3305'
Perf
7000 Acid
Pump 956 Pot
Grav. 30
TD 3347'COMPLETED

Ray Pool

Map No. K133 Sec. 23 Twp. 5 R. 20W

Well No. 7 Graham


Skelly Company

COMPLETE

Contractor

SE SW NW

E 12168
SECTION PLAT

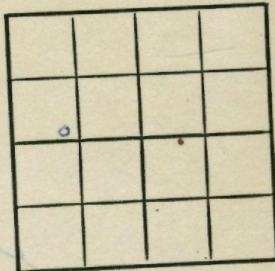

 Ft. from N. Line

330 Ft. from S. Line

 Ft. from E. Line

990 Ft. from W. Line

Phillips County

Location

Rig up

Drilling and Remarks:

Lane 323

5" @ 305

Ref.

Prosser

Pump 956 BT

30° E

RECORD

Cased in., ft.

Sand

Gas

Oil

Total Depth 2247

PRODUCTION

1st 24 hrs. Nat.

1st 24 hrs. after shot

Gas Cu. Ft.

Dry Hole

Abandoned

Date

MAY 21 1947

19

S. J. LEWIS

Scout

Ray Pool

Map No. K133 Sec. 23 Twp. 5 R. 20W

Well No. 7 Graham


Skelly Company

FIRST REPORT

Contractor

SE SW NW

SECTION PLAT

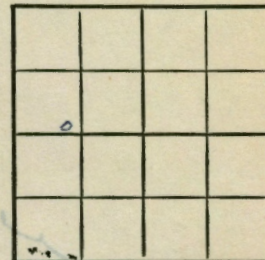

 Ft. from N. Line

330 Ft. from S. Line

 Ft. from E. Line

990 Ft. from W. Line

Phillips County

Location

Rig up

Drilling and Remarks:

R U R

RECORD

Cased in., ft.

Sand

Gas

Oil

Total Depth

PRODUCTION

1st 24 hrs. Nat.

1st 24 hrs. after shot

Gas Cu. Ft.

Dry Hole

Abandoned

Date

APR 16 1947

19

S. J. LEWIS Scout