


KANSAS

Phillips

Section 23 Township 5 Range 20WWell No. #3 Hanson "C"Company Cities Service Oil

NORTH

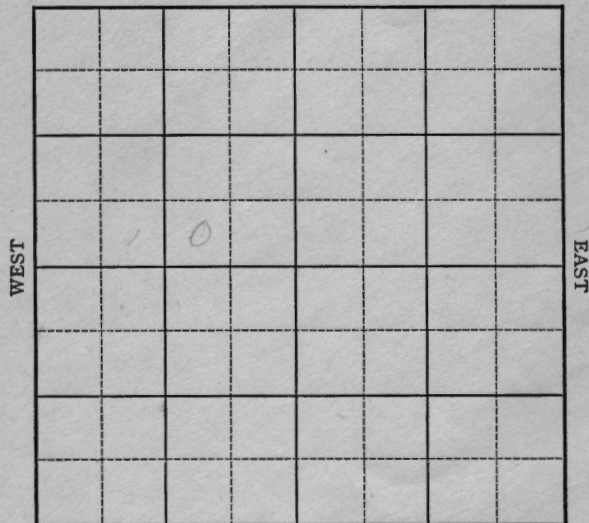

SOUTH

EAST

WEST

6

KANSAS

Phillips County

Sec. 23 Twp. 5 R. 20WWell No. #3 Hansen "C" Farm

Cities Service Oil Company


Ray

Ft. from N. Line

330 Ft. from S. Line990 Ft. from E. Line

Ft. from W. Line

NORTH

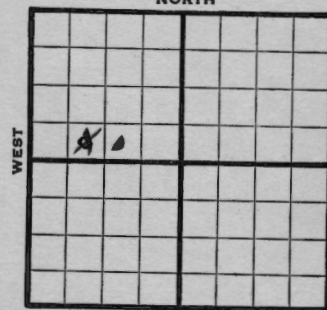

SOUTH

SW SE NW

Elev. 2174

1944

REPORT

8/16

8" @ 155

1624' Dr. 19.

8/23

Arb 3516-70 TD

5" @ 3569 RUST

8/30

Lans 3239

BKC 3465

TD 3585 - 2300' oil 18 hrs.

9/6

Lans 3239

5" @ 3569'

1000' acid.

TD 3585'

Pump 569 Pot.

35.4 Gravity

COMPLETED


KANSAS

Pool Name Hansen PoolMap No. 133 Sec. 23 Twp. 5 R. 20WWell No. 3 Hansen "C"Cities Service Oil Company**COMPLETED**

Contractor

SW SE NW

SECTION PLAT

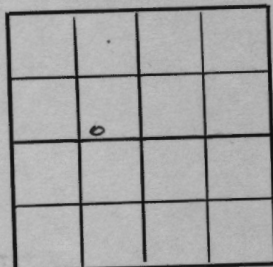

Ft. from N. Line

330 Ft. from S. Line990 Ft. from E. Line

Ft. from W. Line

Phillips County

Location

Rig up

Drilling and Remarks:

Lease 32395 "C 35-6910002220Pay 569000354

RECORD

Cased in, ft.

Sand

Gas

Oil

Total Depth 35-85

PRODUCTION

1st 24 hrs. Nat.

1st 24 hrs. after shot

Gas Cu. Ft.

Dry Hole

Abandoned

Date

SEP 6 1944 19

S. J. LEWIS

Scout


KANSAS

Pool Name RayMap No. 133 Sec. 23 Twp. 5 R. 20WWell No. 3 Hansen "C"Cities Service Oil Company**FIRST REPORT**

Contractor

SW SE NW

SECTION PLAT

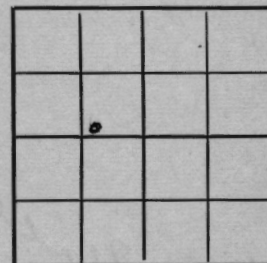

Ft. from N. Line

330 Ft. from S. Line990 Ft. from E. Line

Ft. from W. Line

Phillips

Location

Rig up

Drilling and Remarks:

8 " 1551624

RECORD

Cased in, ft.

Sand

Gas

Oil

Total Depth

PRODUCTION

1st 24 hrs. Nat.

1st 24 hrs. after shot

Gas Cu. Ft.

Dry Hole

Abandoned

Date

AUG 16 1944 19

S. J. LEWIS

Scout