
Phillips county

FORM 51 5M 6-46 PETROL KANSAS

Section 23 Township 5 Range 20-W

Well No. #4, Hansen "C "

Company Cities Service Oil

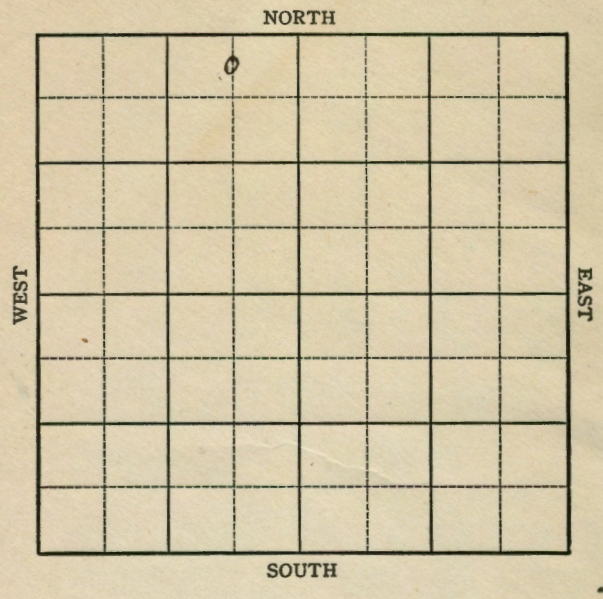

3

5M 6-46 PETROL KANSAS Phillips County

Sec. 23 Twp. 5 R. 20W

Well No. #4 Hansen "C" Farm

Cities Service Company

Hansen


336 Ft. from N. Line

Ft. from S. Line

660 Ft. from E. Line

Ft. from W. Line

CNL NE NW

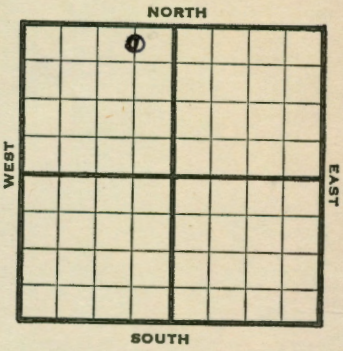

1946	REPORT
	Elev 2163'
8/28	RUR
9/5	8" @ 197
	Drlg 3287'
9/10	Arb 3562
	TD 3569'
	5" @ 3564 RUST
9/18	Lans 3260 '
	48 shots 3329-3356
	1000 acid pump
	262 fluid 22 hrs 5% SS
9/25	Arb 3562'
	5" @ 3564'
	Lans 3260'
	TD 3569'
	Perf Lans
	2000 Acid
	Pump 411 POT
	Grav 30

COMPLETED

FORM 26 200 BKS. 2-44 PETROL

KANSAS Kansas Pool Name Hansen

Map No. 133 Sec. 23 Twp. 5 R. 20W

Well No. 4 Hansen "C"

Cities Service Company

COMPLETED Contractor

C N L NE NW 2-1-2163

SECTION PLAT

336 Ft. from N. Line

Ft. from S. Line

660 Ft. from E. Line

Ft. from W. Line

Phillips County

Location

Rig up

Drilling and Remarks:

Elev 2562
5" 2564
Lane 2260
Prod Lane
Arbuckle
Pump 411 Bbl
80% Oil

RECORD

Cased in., ft.

Sand

Gas

Oil

Total Depth 2569

PRODUCTION

1st 24 hrs. Nat.

1st 24 hrs. after shot

Gas Cu. Ft.

Dry Hole

Abandoned

Date

SEP 25 1946 19

S. J. LEWIS Scout

FORM 56 200 BKS. 1-44 PETROL

KANSAS Kansas Pool Name Hansen

Map No. 133 Sec. 23 Twp. 5 R. 20W

Well No. 4 Hansen "C"

Cities Service Company

FIRST REPORT Contractor

C N L NE NW

SECTION PLAT

336 Ft. from N. Line

Ft. from S. Line

660 Ft. from E. Line

Ft. from W. Line

Phillips County

Location

Rig up

Drilling and Remarks:

R U R

RECORD

Cased in., ft.

Sand

Gas

Oil

Total Depth

PRODUCTION

1st 24 hrs. Nat.

1st 24 hrs. after shot

Gas Cu. Ft.

Dry Hole

Abandoned

Date

AUG 28 1946 19

S. J. LEWIS Scout