



KANSAS
FORM 51 5M 6-46 PETROL Phillips county

Section 23 Township 5 Range 20-W
Well No. #6, Hansen "C"
Company Cities Service Oil Company

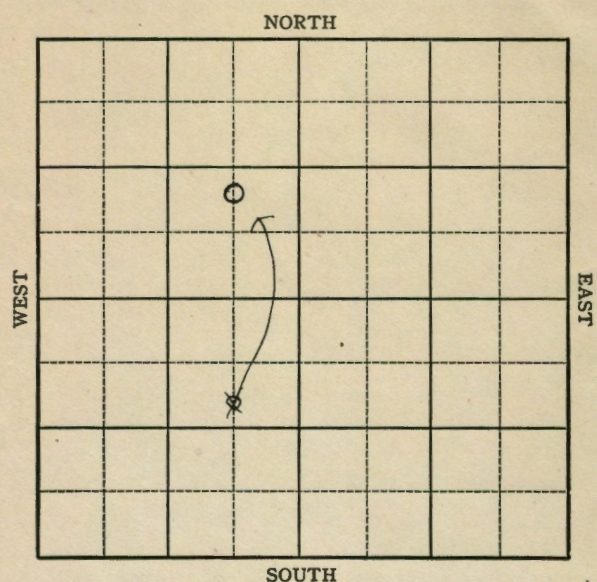

Sec. 23 Twp. 5 R. 20-W
Well No. #6, Hansen "C" Farm
Cities Service Oil Company Company

Hanson
990' Ft. from N. Line
990 Ft. from S. Line
660' Ft. from E. Line
Ft. from W. Line
C N L S E N W
C S L N E S W

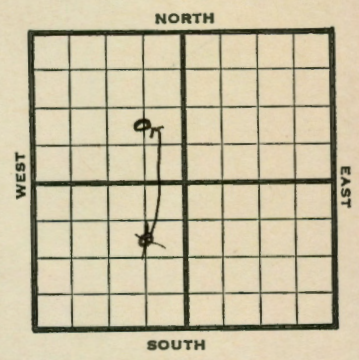

REPORT	
1946	Elev. 2173'
10/19	8" @ 203' Drilling @ 2545'
10/15	Lans 3253 BKC 3409' Arb 3515-24 TD 15" @ 3517 RUST
10/22	48 shots 3321-34, 2000 acid Pump 171 oil 10 hrs, No W
10/30	Arb 3515' 5" @ 3517' Lans 3253' Perf Lans 2000 Acid TD 3524' Pump 490 POT 28 Grav.
COMPLETED	

Map No. 133 Sec. 23 Twp. 5 R. 20WWell No. 6 Hansen "C"

Cities Service


Company

CORRECTION

Contractor

C N L SE NW

SECTION PLAT

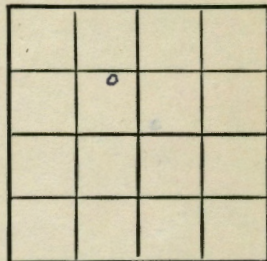

Ft. from N. Line

990 Ft. from S. Line

660 Ft. from E. Line

Ft. from W. Line

Phillips County

Location

Rig up

Drilling and Remarks:

Reported

C S L NE SW

RECORD

Cased in, ft.

Sand

Gas

Oil

Total Depth

PRODUCTION

1st 24 hrs. Nat.

1st 24 hrs. after shot

Gas Cu. Ft.

Dry Hole

Abandoned

Date

OCT 16 1946 19

S. J. LEWIS

Scout

Map No. 133 Sec. 23 Twp. 5 R. 20WWell No. 6 Hansen "C"

Cities Service


Company

FIRST REPORT

Contractor

C S L NE SW

SECTION PLAT

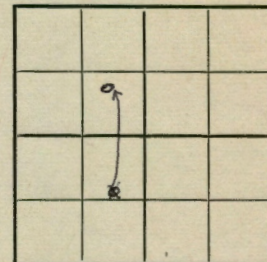

990 Ft. from N. Line

Ft. from S. Line

660 Ft. from E. Line

Ft. from W. Line

Phillips County

Location

Rig up

Drilling and Remarks:

8" @ 203'

2545'

RECORD

Cased in, ft.

Sand

Gas

Oil

Total Depth

PRODUCTION

1st 24 hrs. Nat.

1st 24 hrs. after shot

Gas Cu. Ft.

Dry Hole

Abandoned

Date

OCT 9 1946 19

S. J. LEWIS

Scout

Hansen Pool

Form 26 200 Bks. 10-46 Petrol
KansasMap No. 133 Sec. 23 Twp. 5 R. 20WWell No. 6 Hansen "C"

Cities Service

Company

COMPLETED

Contractor

C N L SE NW

E 12173
SECTION PLAT

Ft. from N. Line

990 Ft. from S. Line660 Ft. from E. Line

Ft. from W. Line

	o		

Phillips County

Location

Rig up

Drilling and Remarks:

Ce X 30755" 23577lane 3258Prof Lane2000 acidPump #90 Bx.

RECORD

Cased _____ in., _____ ft.

Sand _____

Gas _____

Oil _____

Total Depth 3524

PRODUCTION

1st 24 hrs. Nat. _____

1st 24 hrs. after shot _____

Gas _____ Cu. Ft.

Dry Hole _____

Abandoned _____

Date

OCT 30 1946

19

S. J. LEWIS

Scout