


Section 26 Township 5 Range 20W

Well No. #1 Wiltrout

Company Stearn Pet. et al

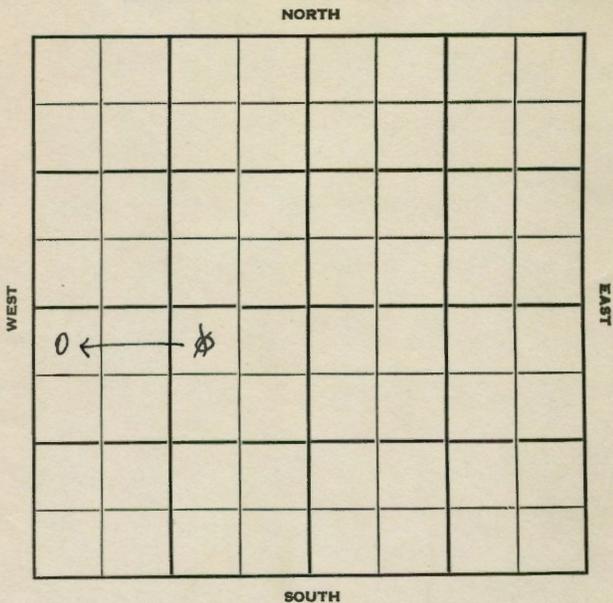

12

Sec. 26 Twp. 5 R. 20 W

Well No. #1 Wiltrout

Stearn Pet. et al

Wildcat


330 Ft. from N. Line

Ft. from S. Line

~~990~~ Ft. from E. Line

330' Ft. from W. Line

NW
NW NE SW

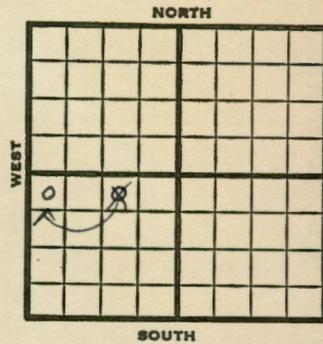

1951 **Elev. 2145'** REPORT

4/4 Location

5/9 Spud 4-19-51
 D & A TD 3667'
 8" @ 202 Heeb 3367', Tor. 3389',
 Lans. 3405', Arb. 3660',
 TD 3667'
 D & A

ABANDONED

Map No. _____ Sec. 26 Twp. 5 R. 20W

Well No. 1 Wiltrout

Stearn Pet. etal. Company

CORRECTION Contractor

NW NW SW

SECTION PLAT

330 Ft. from N. Line

_____ Ft. from S. Line

_____ Ft. from E. Line

330 Ft. from W. Line

0			

Phillips County

Location _____

Rig up _____

Drilling and Remarks:

Reported _____

NW NE SW _____

RECORD

Cased _____ in., _____ ft.

Sand _____

Gas _____

Oil _____

Total Depth _____

PRODUCTION

1st 24 hrs. Nat. _____

1st 24 hrs. after shot _____

Gas _____ Cu. Ft.

Dry Hole _____

Abandoned _____

Date

APR 18 1951 19

J. E. TYRA Scout