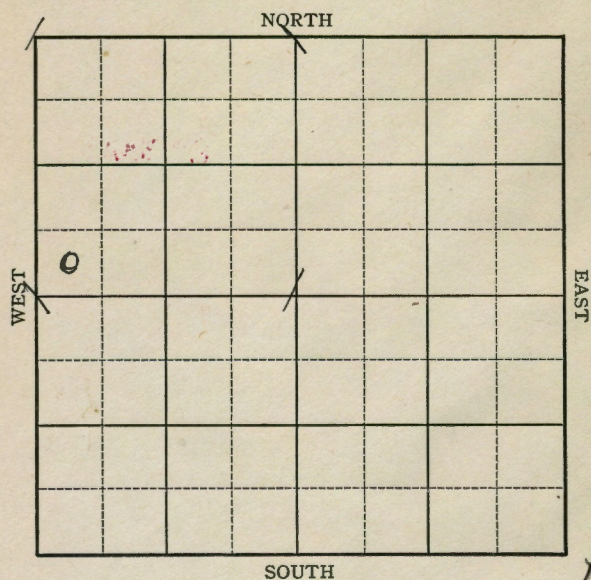


KANSAS

FORM 51 5M 1-42 PETROL

Phillips

Section 27 Township 5 Range 20-WWell No. #1 GriffinCompany Cities Service OilFORM 252-A
5M 9-42 GASS

KANSAS

Phillips

Sec. 27 Twp. 5 R. 20-WWell No. #1 Griffin Far

Cities Service Oil Compar


Ft. from N. Line

330 Ft. from S. Line

Ft. from E. Line

330 Ft. from W. Line

El. 2180

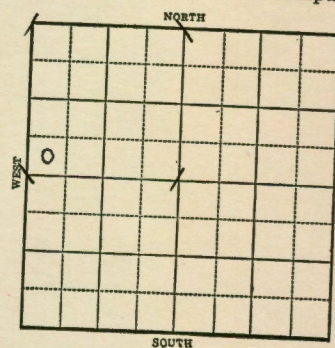

1943

REPORT

2/10 Location
2/17 10" Casing set 156'
Drlg. 2402'

2/24 Neva 2620
Topeka 3070
Lans 3289
Reagan 3652
Granite Wash 3664
Granite ~~3678~~ 3682
TD 3683
7" Casing et ~~3683~~ 3687' RUST
18 shots 3619-22-277 oil in 9 h

3/3

3/10

Lans 3289
Arb. 3568
Reagan 3652
Granite 3682
7" @ 3687'
18 shots 3619-22
Echo Pot. 1109
T.D. 3687'
Gravity 35

COMPLETED

Phillips

KANSAS
Map No. 133 Sec. 27 Twp. 5 R. 20WWell No. 1 Griffin

Cities Service Oil Company

COMPLETED

Contractor


SW NW

SECTION PLAT

Ft. from N. Line

330 Ft. from S. Line

Ft. from E. Line

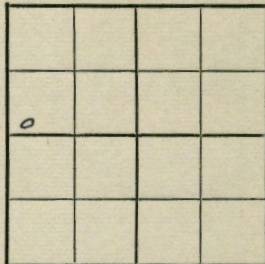330 Ft. from W. Line

RAY POOL

Location

Rig up

Drilling and Remarks:

*Lane 3287**Cir 8 3562**Reagan 3652**Granite 3682**7" C 3687**18 1/2 hrs to 3615-22**Ech 45 1109*

RECORD

Cased _____ in., _____ ft.

Sand _____

Gas _____

Oil _____

Total Depth 3687

PRODUCTION

1st 24 hrs. Nat. _____

1st 24 hrs. after shot _____

Gas _____ Cu. Ft.

Dry Hole _____

Abandoned _____

Date

350 Gr

MAR 10 1943 19

S. J. LEWIS Scout

Phillips

KANSAS
Map No. 133 Sec. 27 Twp. 5 R. 20WWell No. 1 Griffin

Cities Service Oil Company

FIRST REPORT

Contractor


SW NW

SECTION PLAT

Ft. from N. Line

330 Ft. from S. Line

Ft. from E. Line

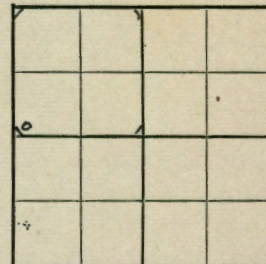330 Ft. from W. Line

RAY POOL

Location XXX

Rig up _____

Drilling and Remarks:

RECORD

Cased _____ in., _____ ft.

Sand _____

Gas _____

Oil _____

Total Depth _____

PRODUCTION

1st 24 hrs. Nat. _____

1st 24 hrs. after shot _____

Gas _____ Cu. Ft.

Dry Hole _____

Abandoned _____

Date

FEB 10 1943 19

S. J. LEWIS Scout