


Section 27 Township 5 Range 20-W

Well No. #2 Griffin

Company Cities Service Oil

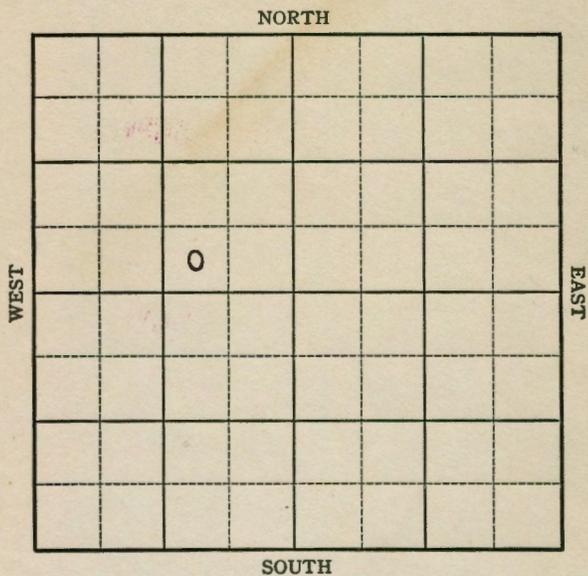

6

Sec. 27 Twp. 5 R. 20-W

Well No. #2 Griffin Farm

Cities Service Oil Company

Ray Pool


_____ Ft. from N. Line

330 Ft. from S. Line

990 Ft. from E. Line

_____ Ft. from W. Line

Elev. 2169

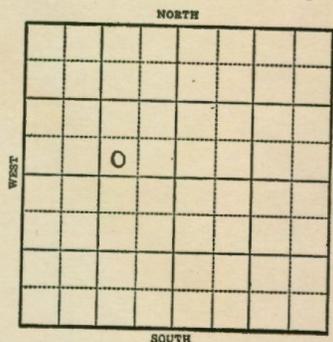

1943

R E P O R T

- 3/10 Location
- 3/16 10" Casing set 165
Drlg. 2058'
- 3/24 **Lans 3305**
Drlg. 3519'
- 3/31 Arb 3560 Reagan 3614 TD 3685-7"
@ 3685 Rust.
- 4/7 5 shots 3617-19-2150' water
Plug 3608-34 shots 3593-97
1500' fluid 8½ hrs
PB 3604
Pump 124 bbls oil in 24 hrs
½% water.
- 4/14 To perforate 3571 to 76
- 4/21 **Lans 3305**
Arb. 3560
Reagan 3614
7" @ 3685'
T.D. 3685'
P.B. 3604'
36 shots 3571-76
Pump 313 Pot.
Gravity 35

COMPLETED

KANSAS Phillips
Map No. 133 Sec. 27 Twp. 5 R. 20W
Well No. 2 Griffin

Cities Service Oil Company
COMPLETED Contractor

SW SE NW

SECTION PLAT

	o		

_____ Ft. from N. Line
330 Ft. from S. Line
990 Ft. from E. Line
_____ Ft. from W. Line

RAY POOL

Location _____
Rig up _____
Drilling and Remarks:
Lane 3305
Co Y 3560
Reagan 3614
7" C 3675
PB 3604
3640 to 3571-76
Pump 313 Pa Y
352 Gr
Date _____

RECORD
Cased _____ in., _____ ft.
Sand _____
Gas _____
Oil _____
Total Depth 3675

PRODUCTION
1st 24 hrs. Nat. _____
1st 24 hrs. after shot _____
Gas _____ Cu. Ft.
Dry Hole _____
Abandoned _____

APR 21 1943 19

S. J. LEWIS Scout

KANSAS Phillips
Map No. 33 Sec. 27 Twp. 5 R. 20W
Well No. 2 Griffin

Cities Service Oil Company
FIRST REPORT Contractor

SW SE NW

SECTION PLAT

	o		

_____ Ft. from N. Line
330 Ft. from S. Line
990 Ft. from E. Line
_____ Ft. from W. Line

RAY POOL

Location XXX
Rig up _____
Drilling and Remarks:

RECORD
Cased _____ in., _____ ft.
Sand _____
Gas _____
Oil _____
Total Depth _____

PRODUCTION
1st 24 hrs. Nat. _____
1st 24 hrs. after shot _____
Gas _____ Cu. Ft.
Dry Hole _____
Abandoned _____

Date _____
MAR 10 1943 19

S. J. LEWIS Scout