

KANSAS


FORM 51 5M 6-46 PETROL

Phillips County

Section 27 Township 5 Range 20-W

Well No. #3 Griffin

Company Cities Ser.

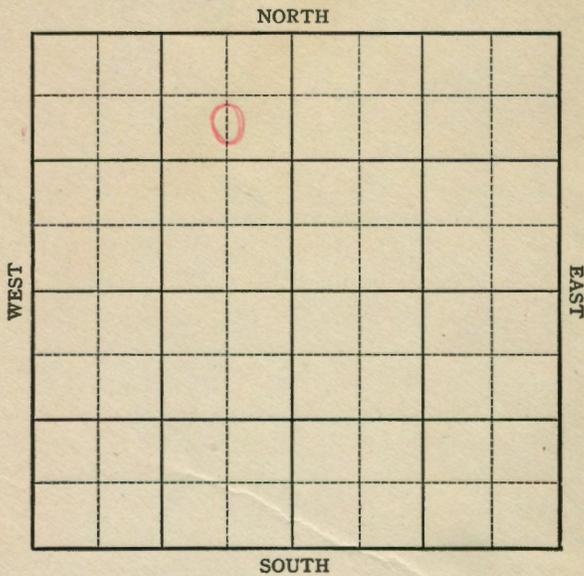

3

5M 6-46 PETROL

KANSAS

Phillips County

Sec. 27 Twp. 5 R. 20W

Well No. #3 Griffin Farm _____

Cities Service Company _____


Hansen
990 Ft. from N. Line

_____ Ft. from S. Line

660 Ft. from E. Line

_____ Ft. from W. Line

CSL NE NW

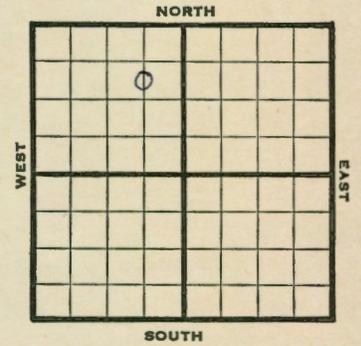

1946

Elev 2179'

REPORT

7/31

Location

8/6

8" @ 205
Drlg 2080'

8/13

Arb 3597
TD 3618'
5" @ 3618 RUST

8/13

Lans 3316
59 shots 3595-3608
Pump 66 fluid in 24 hrs
1 1/2% wtr.

8/27

" " "

9/5

" " "

9/11

Arb 3594'
5" @ 3 615'
Perf 500 acid
TD 3615
Pump 98 oil & 2% Water Pot
Gravity 27

COMPLETED

Pool Name Hansen Pool
Kansas

Map No. 133 Sec. 27 Twp. 5 R. 20W

Well No. 3 Griffin

Cities Service Company

COMPLETED

Contractor

C S L NE NW

E 12/79
SECTION PLAT

990 Ft. from N. Line

Ft. from S. Line

660 Ft. from E. Line

Ft. from W. Line

Phillips County

Location

Rig up

Drilling and Remarks:

Art 3594

5" @ 615

Prof. Stacid

Pump 98 or 6 + 29%

Art

27 lbs

RECORD

Cased _____ in. _____ ft.

Sand _____

Gas _____

Oil _____

Total Depth 3615

PRODUCTION

1st 24 hrs. Nat. _____

1st 24 hrs. after shot _____

Gas _____ Cu. Ft.

Dry Hole _____

Abandoned _____

Date

SEP 11 1946 19

S. J. LEWIS Scout

Pool Name Hansen
KANSAS Kansas

Map No. _____ Sec. 27 Twp. 5 R. 20W

Well No. 3 Griffin

Cities Service Company

FIRST REPORT

Contractor

C S L NE NW

SECTION PLAT

990 Ft. from N. Line

Ft. from S. Line

660 Ft. from E. Line

Ft. from W. Line

Phillips County

Location X

Rig up

Drilling and Remarks:

RECORD

Cased _____ in. _____ ft.

Sand _____

Gas _____

Oil _____

Total Depth _____

PRODUCTION

1st 24 hrs. Nat. _____

1st 24 hrs. after shot _____

Gas _____ Cu. Ft.

Dry Hole _____

Abandoned _____

Date

JUL 31 1946 19

S. J. LEWIS Scout