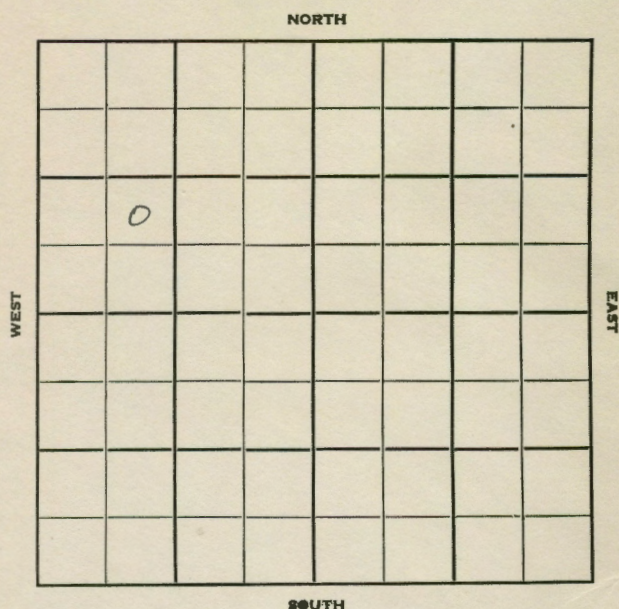


Section 27 Township 5 **KANSAS** Range 20WWell No. #4 GriffinCompany Cities Service Oil

5

Sec. 27 Twp. 5 R. 20 W ✓Well No. #4 Griffin FarmCities Service Oil CompanyRine Drlg. ContractorRay Pool


Ft. from N. Line

990 Ft. from S. Line

Ft. from E. Line

990 Ft. from W. Line

NE SW NW

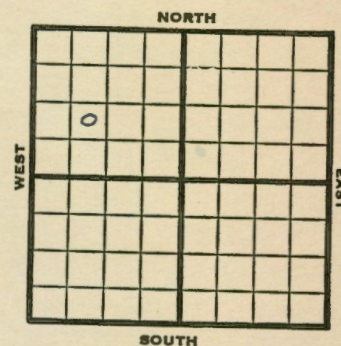1951 **Elev. 2184'** REPORT5/9 Spud 5-7-51
8" @ 200'

6/20 Spud 5-7-51
Oil Well TD 3611
8" @ 200
Heeb. 3282 Dodge 3304
Lans. 3323 ReArb 3574
Arb. 3577-87
5" @ 3583
TD 3611
2500 A
Comp. 282 bopd

COMPLETED

County	Phillips	State	Kansas
Sec.	27 (Blk. Twp.)	5 (Sur. Rge.)	20W Map No.
Operator	Cities Service Oil		
Well No.	4	Farm	Griffin
Elev.	2184	Location	NE SW NW

990	Ft. From	S	Line	NW
990	Ft. From	W	Line	Quarter
1st. Report				
Completion		JUN 20 1951		
Remarks		Ray Pool		
		Rine Drlg. - Contr.		
Spudding Date		5-7-51		

Drig. Data	Oil well	TD 3611
8" @ 200	Heeb. 3282	Dodge 3304
Lans. 3323	ReArb. 3574	Arb. 3577-87
5" @ 3583	TD 3611	2500 A
Comp. 282 bopd		

J. E. TYRA

County	Phillips		State	Kansas	
Sec.	27	(Bk. Twp.)	5	(Sur. Rge.)	20W Map No.
Operator	Cities Service Oil				
Well No.	4	Farm	Griffin		
Elev.	Location NE SW NW				

0

FIRST REPORT

990 Ft. From	S Line	NW
990 Ft. From	W Line	Quarter
1st. Report	MAY	9 1951
Completion		
Remarks		
Rine Drlg. - Contr.		
Spudding Date	8-7-51	

Orig. Data Ray Pool

8th © 200

J. E. TYRA