

KANSAS


FORM 51 5M PETROL

Phillips

Section 27 Township 5 Range 20-W

Well No. #1 Hartshorn

Company Cities Service Oil

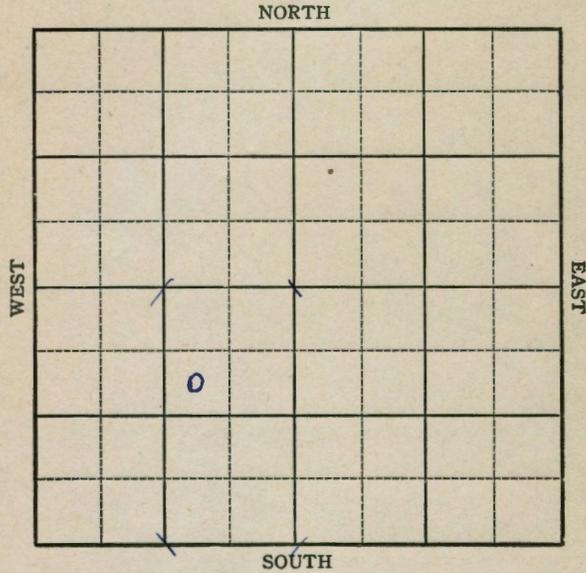

11

FORM 252-A
5M 9-43 GASS


KANSAS

Phillips

Sec. 27 Twp. 5 R. 20-W

Well No. #1 Hartshorn Farm _____

Company Cities Service Oil

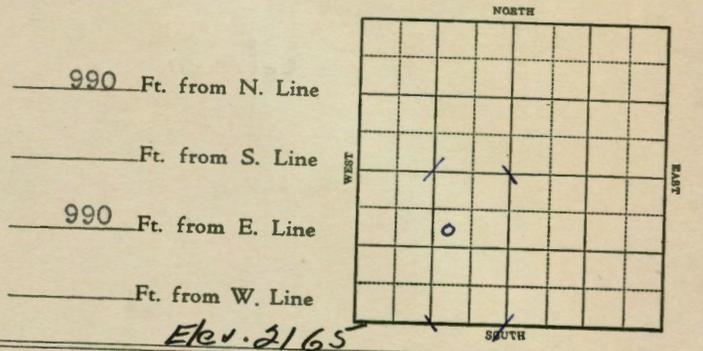

1943 REPORT	
10/6	Derrick
10/13	8" @ 1580 Drlg. 2035'
10/20	Reagan 3597' T.D. 3630SD
10/27	Gorham 3597' Corrected Lans 3321 Aro 3617 T.D. 3630 5" @ 3630 60 shots 3596-3608 60 shots 3347-58 12 shots 3608-10 12 shots 3321-23-1/2 bailer WPH
11/3	24 shots 3503-07 24 shots 3302-08 PB 3490-1000 acid
11/10	Pump 54 fluid 18 hrs 70% water 2000 acid Pump 3 1/2 fluid PH 75% Water

OVER

1943
11/17

Arb 3617
5" @ 3630
Perf. Gorhan & Lansing
Water
T.D. 3630

ABANDONED

Form 26 200 Bks. 5-42 Petrol **Phillips**
KANSAS
 Map No. 133 Sec. 27 Twp. 5 R. 20W
 Well No. 1 Hartshorn


Cities Service Oil Company

ABANDONED Contractor

SW NE SW

SECTION PLAT

990 Ft. from N. Line
 _____ Ft. from S. Line
990 Ft. from E. Line
 _____ Ft. from W. Line

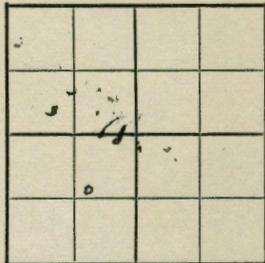

Ray Pool

Location _____

Rig up _____

Drilling and Remarks:

*Oil 4361?
 5' @ 3630
 Prof. Str. ham &
 Learning Water.*

RECORD

Cased _____ in., _____ ft.
 Sand _____
 Gas _____
 Oil _____
 Total Depth 3630

PRODUCTION

1st 24 hrs. Nat. _____
 1st 24 hrs. after shot _____
 Gas _____ Cu. Ft.
 Dry Hole _____
 Abandoned _____

Date

NOV 17 1943 19

S. J. LEWIS Scout

Form 26 200 Bks. 5-42 Petrol **Phillips**
KANSAS
 Map No. 133 Sec. 27 Twp. 5 R. 20 ^W

Well No. 1 Hartshorn


Cities Service Oil Company

FIRST REPORT Contractor

SW NE SW

SECTION PLAT

990 Ft. from N. Line
 _____ Ft. from S. Line
990 Ft. from E. Line
 _____ Ft. from W. Line

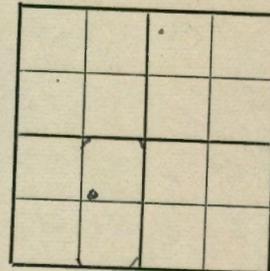

Ray Pool

Location _____

Rig up _____

Drilling and Remarks:

Derrick

RECORD

Cased _____ in., _____ ft.
 Sand _____
 Gas _____
 Oil _____
 Total Depth _____

PRODUCTION

1st 24 hrs. Nat. _____
 1st 24 hrs. after shot _____
 Gas _____ Cu. Ft.
 Dry Hole _____
 Abandoned _____

Date

OCT 6 1943 19

S. J. LEWIS Scout