

KANSAS


Phillips

FORM 51 5M 10-41 PETROL

Section 27 Township 5 Range 20-W

Well No. #1 Pierson "B"

Company Cities Service Oil

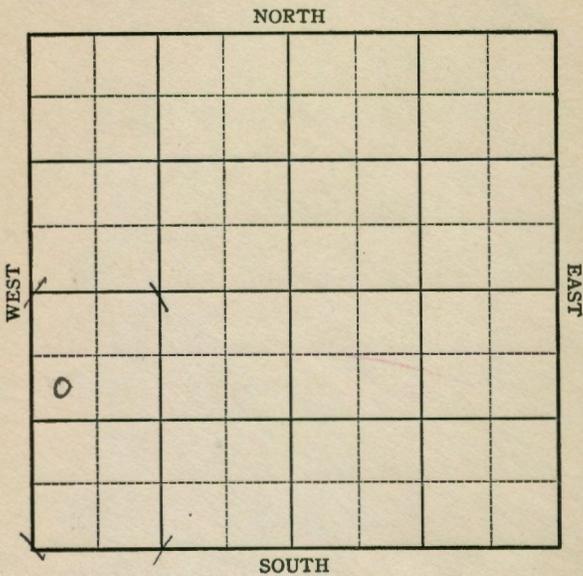

12

Form 252-A  
5M 5-42 Petrol

KANSAS

Phillips

Sec. 27 Twp. 5 R. 20-W

Well No. #1 Pierson "B" Farm

Cities Service Oil Company


Ray Pool

990 Ft. from N. Line

\_\_\_\_\_ Ft. from S. Line

\_\_\_\_\_ Ft. from E. Line

330 Ft. from W. Line

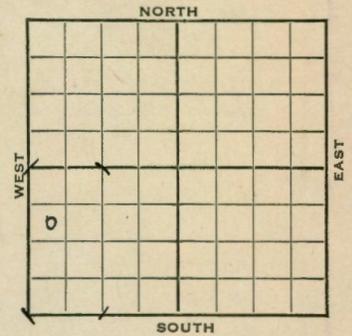

SW NW SW Elev. 2145

1943	REPORT
1/6	Derrick
1/13	10" casing set 151' Drlg. 2125'
1/20	Sand 3539 TD 3641 SD.
1/27	Lans 3296 Arbuckle 3549 Regan 3572 Granite Wash. 3598 Granite 3636 TD 3640 7" Casing set 3640' 12 shots 3570-74-2850' oil 3 hrs
2/3	Reagan 3572 Granite wash 3598 Granite 3636 7" casing set 3640' 12 shots 3570-74 T.D. 3640' Depth Pot 5626' Max. 3000 Gravity 35

COMPLETED

Phillips

KANSAS

Map No. 33 Sec. 27 Twp. 5 R. 20W

Well No. 1 Pierson "B"

Cities Service Oil Company

FIRST REPORT Contractor

SW NW SW

SECTION PLAT

990 Ft. from N. Line

Ft. from S. Line

Ft. from E. Line

330 Ft. from W. Line


RAY POOL

Location

Rig up

Drilling and Remarks:

Derrick

RECORD

Cased in, ft.

Sand

Gas

Oil

Total Depth

PRODUCTION

1st 24 hrs. Nat.

1st 24 hrs. after shot

Gas Cu. Ft.

Dry Hole

Abandoned

Date

JAN 6 1943 19

S. J. LEWIS Scout

Phillips

KANSAS

Map No. 33 Sec. 27 Twp. 5 R. 20W

Well No. 1 Pierson "B"

Cities Service Oil Company

COMPLETED Contractor

SW NW SW

SECTION PLAT

990 Ft. from N. Line

Ft. from S. Line

Ft. from E. Line

330 Ft. from W. Line


RAY POOL

Location

Rig up

Drilling and Remarks:

Reagan 3572  
 Granite Wash 3578  
 Granite 3636  
 7" C 3640  
 124 hrs to 3570-94  
 Dept. PY 5626  
 May 3000  
 3250 ft.

RECORD

Cased in, ft.

Sand

Gas

Oil

Total Depth 3640

PRODUCTION

1st 24 hrs. Nat.

1st 24 hrs. after shot

Gas Cu. Ft.

Dry Hole

Abandoned

Date

FEB 3 1943 19

S. J. LEWIS Scout