


KANSAS

Phillips

FORM 51 5M PETROL

Section 27 Township 5 Range 20-WWell No. #2 Pearson "B"Company Cities Ser.

NORTH

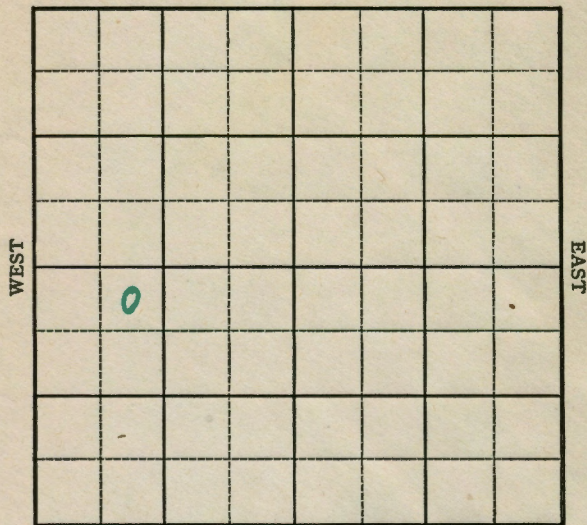

SOUTH

12

5M 8-45 PETROL

KANSAS

Phillips County

Sec. 27 Twp. 5 R. 20WWell No. #2 Pearson "B" FarmCities Service Company

Ray


330 Ft. from N. Line

Ft. from S. Line

Ft. from E. Line

990 Ft. from W. Line

NE NW SW

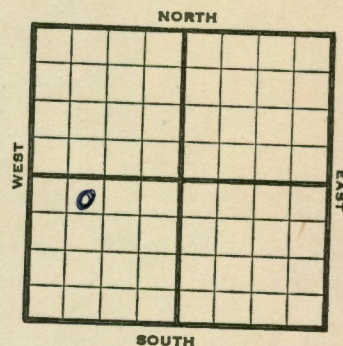

1945

Elev. 2173

REPORT

12/19

RUR

12/29

8" - 158' Drlg. 3255'

1946

1/7

Lans. 3296' Arb. 3546' Reagan 3611'

T.D. 3628' 5" - 3628'

23 shots 3595-99'

Pump 293 fluid 17 hours, 5% water.

1/17

Pump 301 fluid in 20 hours, 37% wtr. Squeeze.

1/24

30 shots 3595-3608'

1850' water. Squeeze.

1/31

12 shots 3597-3601

12 " 3604-3608' 750' oil & 1750' water. Squeeze.

24 shots 3597-3601' Pump 221 fluid in 22 hours, 22% water.

2/7

Pump 151 fluid 12 hours, 30% water.

2/13

Lans 3296

Arb. 3546

5" @ 3628

TD 3628

Perf. Arb.

Pump 189 oil plus 81 wtr. Pot.

Grav. 35.0

COMPLETED

KANSASKansas Pool Name RayMap No. 133 Sec. 27 Twp. 5 R. 20WWell No. 2 Pearson "B"

Cities Service

Company

COMPLETED

Contractor


NE NW SW

SECTION PLAT

330 Ft. from N. Line

Ft. from S. Line

Ft. from E. Line

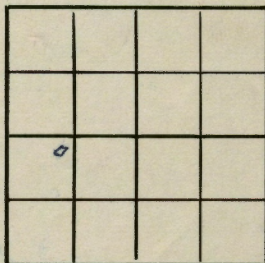990 Ft. from W. Line

Phillips County

Location

Rig up

Drilling and Remarks:

Log 3296
Q 72546
0 72546
Pay for
Pump 189 inch 787
W. B. D.
3500

RECORD

Cased in, ft.

Sand

Gas

Oil

Total Depth 3628

PRODUCTION

1st 24 hrs. Nat.

1st 24 hrs. after shot

Gas Cu. Ft.

Dry Hole

Abandoned

Date

FEB 13 1946 19

S. J. LEWIS

Scout

KANSASKansas Pool Name RayMap No. K-133 Sec. 27 Twp. 5 R. 20WWell No. 2 Pearson "B"

Cities Service

Company

FIRST REPORT

Contractor


NE NW SW

SECTION PLAT

330 Ft. from N. Line

Ft. from S. Line

Ft. from E. Line

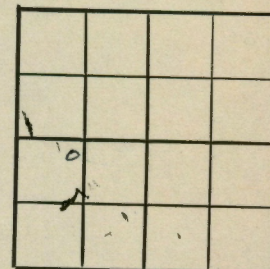990 Ft. from W. Line

Phillips County

Location

Rig up

Drilling and Remarks:

RUR

RECORD

Cased in, ft.

Sand

Gas

Oil

Total Depth

PRODUCTION

1st 24 hrs. Nat.

1st 24 hrs. after shot

Gas Cu. Ft.

Dry Hole

Abandoned

Date

DEC 19 1945 19

S. J. LEWIS

Scout