


Phillips county

Section 27 Township 5 Range 20-W

Well No. #3, Pierson "B"

Company Cities Service Oil Company

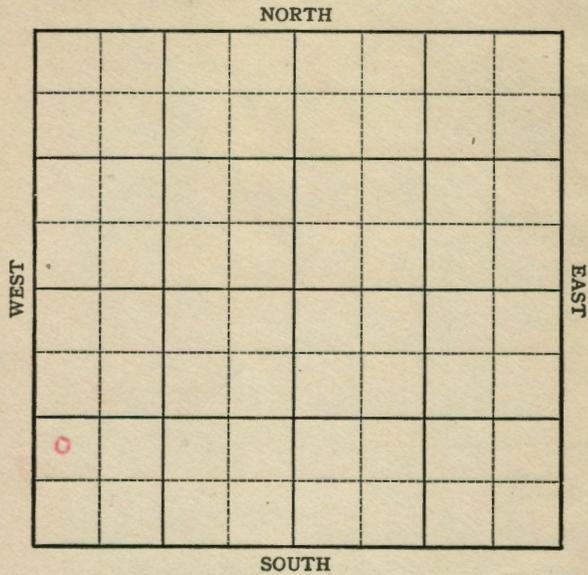

5M 6-46 PETROL **KANSAS** Phillips

Sec. 27 Twp. 5 R. 20W

Well No. 3 Pierson "B" Farm _____

Cities Service Company

Hansen

_____ Ft. from N. Line

990 Ft. from S. Line

_____ Ft. from E. Line

330 Ft. from W. Line

NW SW SW

REPORT	
1946	Elev. 2150
11/20	Location
11/27	Derrick
12/3	8" @ 197' Drlg 2860'
12/10	Lans 3297' Arb 3568' TD 3573' 5" @ 3369', RUST
12/17	5" @ 3569' RUST corrected
1947	
1/4	Regan 3576 TD3578' 75' oil plus 600' W in 7 hrs PB 3573'
1/8	, " " "
1/15	35 shots 3475-86 12 " 3489-93 44 " 3386-96 1000 Acid
1/21	Plug 3450-2000 Acid 3386-96 Plump 50 oil to 16% W in 17 hrs

OVER

2/30 37 shots 3369-78
1500 Acid
Swb 55 oil & 5 W in 19 hrs

2/5 57 shots 3328-39
1500 Acid
Pump 99 oil & 7% W in 24 hrs

2/12 " " "

2/19 " " "

2/26 " " "

3/4 Pump 99 bbls oil & 7% W 24 hrs

3/11 " "

3/26 **Lans 3297**
Reagan 3576
5" @ 3569
Perf Lans
3000 Acid
Pump 173 oil & 8% water Pot
Grav. 33
TD 3578'

COMPLETED

Map No. 133 Sec. 27 Twp. 5 R. 20W

Well No. 3 Pierson "B"

Cities Service Company

FIRST REPORT Contractor

NW SW SW


SECTION PLAT

 Ft. from N. Line

990 Ft. from S. Line

 Ft. from E. Line

330 Ft. from W. Line

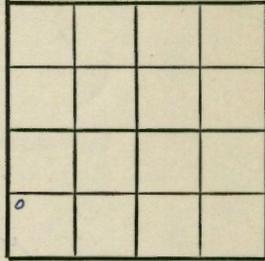

Phillips County

Location X

RECORD

Rig up

Drilling and Remarks:

Cased in., ft.

Sand

Gas

Oil

Total Depth

PRODUCTION

1st 24 hrs. Nat.

1st 24 hrs. after shot

Gas Cu. Ft.

Dry Hole

Abandoned

Date

NOV 20 1946 19

S. J. LEWIS Scout

Map No. 133 Sec. 27 Twp. 5 R. 20W

Well No. 3 Pierson "B"

Cities Service Company

COMPLETE Contractor

NW SW SW


SECTION PLAT

 Ft. from N. Line

990 Ft. from S. Line

 Ft. from E. Line

330 Ft. from W. Line

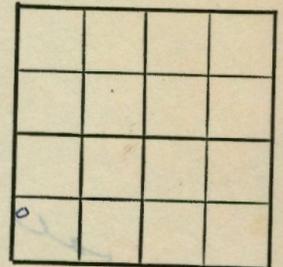

Phillips County

Location

RECORD

Rig up

Drilling and Remarks:

Cased in., ft.

Sand

Gas

Oil

Total Depth

PRODUCTION

1st 24 hrs. Nat.

1st 24 hrs. after shot

Gas Cu. Ft.

Dry Hole

Abandoned

*lane 329
Regan 356
K 356
Perf lane.
3200
Pump 123 oil 78%
P.T. 329*

Date

MAR 26 1947 19

S. J. LEWIS Scout