

Section 27 Township 5 Range 20W


Sec. 27 Twp. 5 R. 20W

Well No. #2 Steele

Well No. #2 Steele Farm _____

Company Cities Service
Ray Pool

Cities Service Company _____
Ray Pool

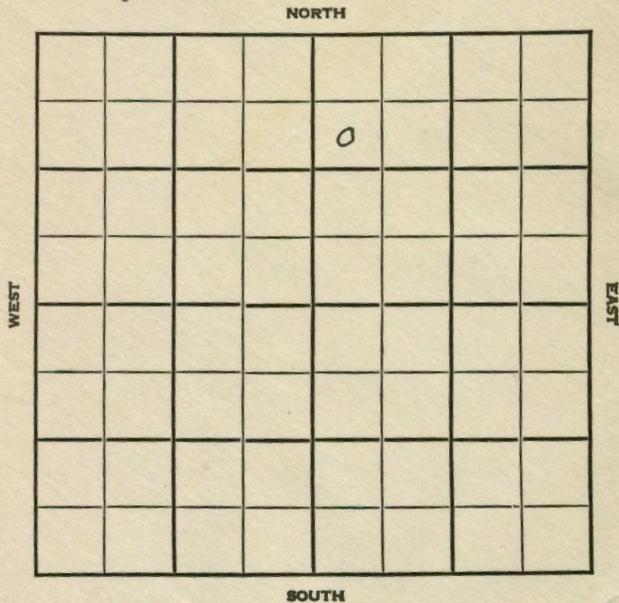


990' Ft. from N. Line

_____ Ft. from S. Line

_____ Ft. from E. Line

330' Ft. from W. Line

SW NW NE

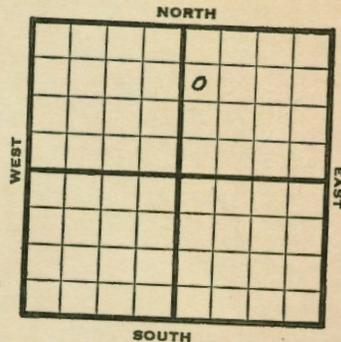

1948 **Elev. 2166'** REPORT

7/21	Location
7/28	"
8/4	"
8/11	8" @ 185' Drlg 3310'
8/18	Lansing 3308' Arbuckle 3601'-06' TD 3606' 5" @ 3602' RUST
8/25	TD 3612' PB 3558' 43 shots 3381-96' 36 shots 3403-14'
9/1	"
9/8	Arbuckle 3601' 5" @ 3602' TD 3612'

ABANDONED

2

Phillips County Kansas State 20W
Map No. 133 Sec. 27 Twp. 5 R.
Well No. 2 Steele

Cities Service Company
ABANDONED Contractor

SW NW NE

E1,2166 SECTION PLAT

990 Ft. from N. Line
Ft. from S. Line
Ft. from E. Line
330 Ft. from W. Line

Ray Pool

Remarks:

Art 3601
5" 03602
7/28/12

ABANDONED



Date SEP 8 1948

Scout S. J. LEWIS

Ray Pool

Map No. Sec. 27 Twp. 5 R. 20W

Well No. 2 Steele

Cities Service Company

FIRST REPORT

Contractor

SW NW NE

SECTION PLAT

990 Ft. from N. Line
Ft. from S. Line
Ft. from E. Line
330 Ft. from W. Line

Phillips County

Location x

Rig up

Drilling and Remarks:

RECORD

Cased in., ft.
Sand
Gas
Oil
Total Depth

PRODUCTION

1st 24 hrs. Nat.
1st 24 hrs. after shot
Gas Cu. Ft.
Dry Hole
Abandoned

Date

JUL 21 1948

19

S. J. LEWIS

Scout