


KANSAS

Section 28 Township 5 Range 20W
Well No. 1 Reese "E"
Company Cities Service Oil
RAY POOL

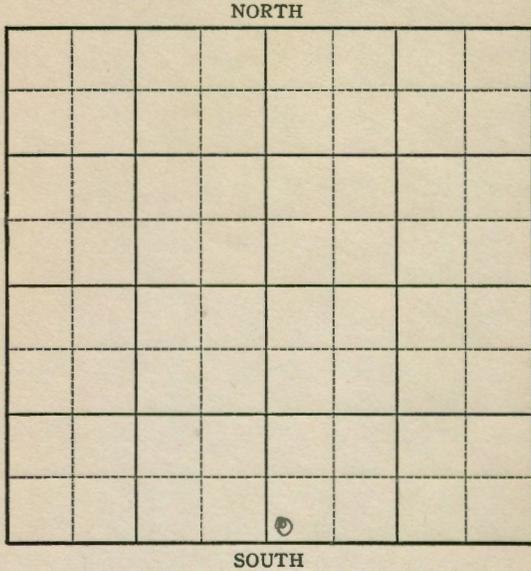


15

KANSAS Phillips

Sec. 28 Twp. 5 R. 20-W
Well No. #1 Reese "E" Farm _____
Cities Service Oil Company _____
(Ray Pool)

_____ Ft. from N. Line
330 Ft. from S. Line
_____ Ft. from E. Line
330 Ft. from W. Line

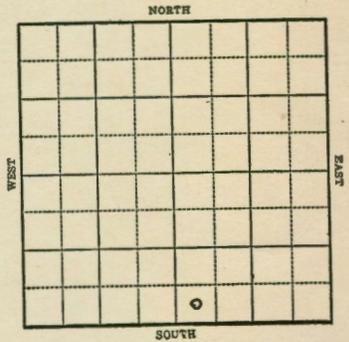

Elev. 2163'

1942		REPORT
10/14	Derrick.	
10/21	10" @ 155' Drlg 2907	
10/29	Gorham 3543 SD Granite Wash 3630 Granite 2690 T D 2692	
11/4	Topeka 3100 Lans 3270 7" @ 3692 25 shots 3570-78. 2700 oil 5½ hrs.	
11/11	" "	
11/18	" "	
11/24	" "	
12/2	" "	
12/9	Arb. 3553 Reagan 3574 Granite 3690 7" - 3692 Perf. Reagan T.D. 3692 Depth Pot. 1629 Gravity 35.	

COMPLETED

