

KANSAS


Phillips

FORM 51 5M 1-42 PETROL

Section 28 Township 5 Range 20WWell No. #2 Reese "E"Company Cities Service Oil

Ray pool

NORTH

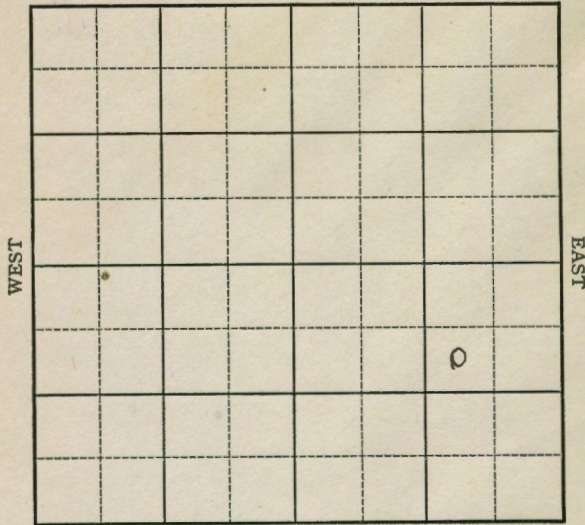

SOUTH

9

Form 252-A  
5M 5-42 Petrol

KANSAS

Phillips

Sec. 28 Twp. 5 R. 20WWell No. #2 Reese "E" FarmCompany Cities Service Oil


Ray Pool

990 Ft. from N. Line

Ft. from S. Line

990 Ft. from E. Line

Ft. from W. Line

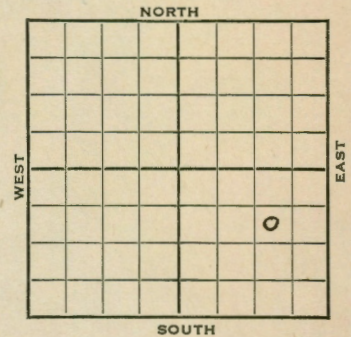

Elev. 2171

1942

REPORT

11/10 Derrick  
11/18 10" @ 160  
Drlg. 3363

11/24 BKC 3512  
Arb. 3569  
Reagan 3618  
Granite wash 3672  
Granite 3685  
TD 3694'  
7" @ 3694' Rust.

12/2 " "

12/9 24 shots 3597-3600-2650 Oil in  
6 3/4 hrs

12/16 Reagan 3618  
Granite 3691  
7" @ 3694'  
T.D. 3694'  
24 shots 3597-3600  
Depth to Pot. 1689  
Gravity 35

COMPLETED

KANSAS

Map No. 133 Sec. 28 Twp. 5 R. 20WWell No. 2 Reese "E"

Cities Service Oil

Company

COMPLETED

Contractor

SW NE SE


SECTION PLAT

990 Ft. from N. Line

Ft. from S. Line

990 Ft. from E. Line

Ft. from W. Line

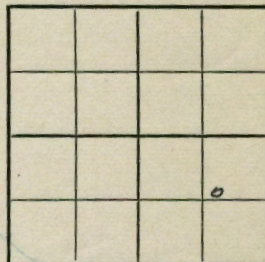

RAY POOL

Location

Rig up

Drilling and Remarks:

*Reagon 3618**Granite 8691**2" C 3694**24 in hole 3557-3600**Dep. H. A. Y.**1689**35-2-42*

Date

DEC 16 1942

19

S. J. LEWIS

Sc

## RECORD

Cased 1 in. 1 ft.

Sand

Gas

Oil

Total Depth 3694

## PRODUCTION

1st 24 hrs. Nat.

1st 24 hrs. after shot

Gas 1689 Cu. Ft.

Dry Hole

Abandoned

KANSAS

Map No. 133 Sec. 28 Twp. 5 R. 20WWell No. 2 Reese "E"

Cities Service Oil

Company

FIRST REPORT

Contractor

SW NE SE


SECTION PLAT

990 Ft. from N. Line

Ft. from S. Line

990 Ft. from E. Line

Ft. from W. Line

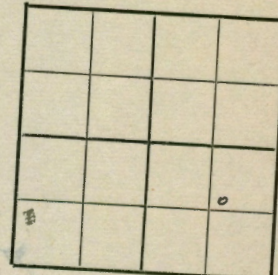

RAY POOL

Location

Rig up

Drilling and Remarks:

Derrick

## RECORD

Cased 1 in. 1 ft.

Sand

Gas

Oil

Total Depth

## PRODUCTION

1st 24 hrs. Nat.

1st 24 hrs. after shot

Gas 1689 Cu. Ft.

Dry Hole

Abandoned

Date

NOV 11 1942

19

S. J. LEWIS

Scout