

KANSAS


Phillips

FORM 51 5M 1-42 PETROL

Section 28 Township 5 Range 20-W

Well No. #3 Reese "E"

Company Cities Service Oil

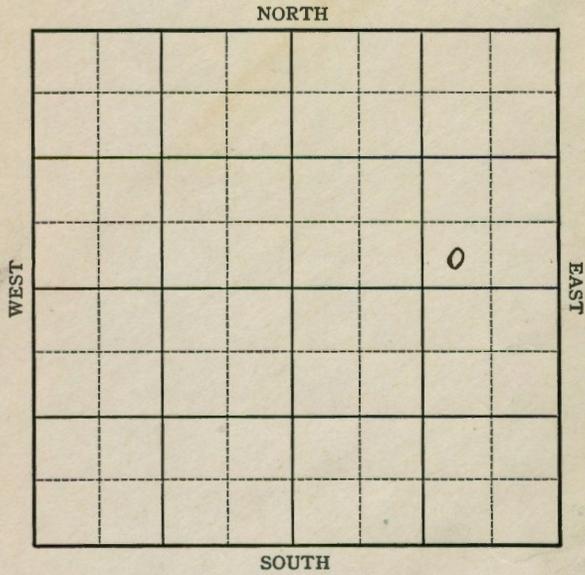

8

FORM 252-A
5M 9-42 GASS

KANSAS

Phillips

Sec. 28 Twp. 5 R. 20-W

Well No. #3 Reese "E" Farm

Cities Service Oil Company

Ray


_____ Ft. from N. Line

330 Ft. from S. Line

990 Ft. from E. Line

_____ Ft. from W. Line

Elev. 2170

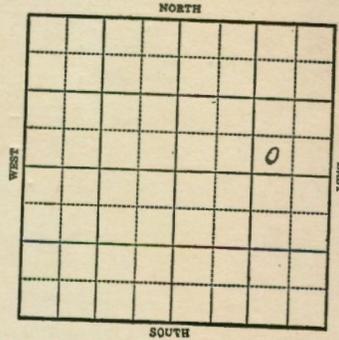

1943

REPORT

4/14 Location.
 4/21 8" @ 156'
 Drlg. 3011'
 4/28 Lans 3276
 Arb 3557
 Reagan 3622
 Granite Wash 3670
 Granite 3698
 T.D. 3699
 5" @ 3699 RUST.
 5/5 " " "
 5/12 " " "
 5/22 " " "
 5/26 " " "
 6/2 Arb 3562 Corrected
 Reagan 3627
 Granite Wash 3675
 Granite 3703-04 T.D.
 5" @ 3704'
 12 shots 2621-23-2400' water $\frac{1}{2}$ hr
 6/9 34 shots 3585-91-2700' oil
 84 shots 3561-75 no inc.

OVER

1943
6/16

Arb. 3562

Granite 3703

5" @ 3704'

T.D. 3704'

5" @ 3704'

34 shots 3585-91

84 shots 3561-75

Pump 389 Pot.

Gravity 35

COMPLETED

KANSAS

Map No. 133 Sec. 28 Twp. 5 R. 20W

Well No. 3 Reese "E"

Cities Service Oil Company

COMPLETED Contractor

SW SE NE


SECTION PLAT

Ft. from N. Line

330 Ft. from S. Line

990 Ft. from E. Line

Ft. from W. Line

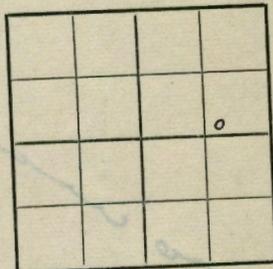

RAY POOL

Location

Rig up

Drilling and Remarks:

Case 3562
Granite 3703
5" C 3704
34' hole to 8575-91
74 " 3561-95
Only 389' Pat.
352 91

Date

JUN 16 1943 19

RECORD

Cased in, ft.

Sand

Gas

Oil

Total Depth 3704

PRODUCTION

1st 24 hrs. Nat.

1st 24 hrs. after shot

Gas Cu. Ft.

Dry Hole

Abandoned

S. J. LEWIS Scout

KANSAS

Map No. 133 Sec. 28 Twp. 5 R. 20W

Well No. 3 Reese "E"

Cities Service Oil Company

FIRST REPORT Contractor

SW SE NE


SECTION PLAT

Ft. from N. Line

330 Ft. from S. Line

990 Ft. from E. Line

Ft. from W. Line

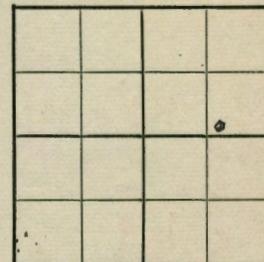

RAY POOL

Location XXX

Rig up

Drilling and Remarks:

Total Depth

RECORD

Cased in, ft.

Sand

Gas

Oil

Total Depth

PRODUCTION

1st 24 hrs. Nat.

1st 24 hrs. after shot

Gas Cu. Ft.

Dry Hole

Abandoned

Date

APR 14 1943 19

S. J. LEWIS Scout