

KANSAS

FORM 51 5M 1-42 PETROL


Phillips

Section 28 Township 5 Range 20-W

Well No. #4 Reece "E"

Company Cities Service Oil

NORTH

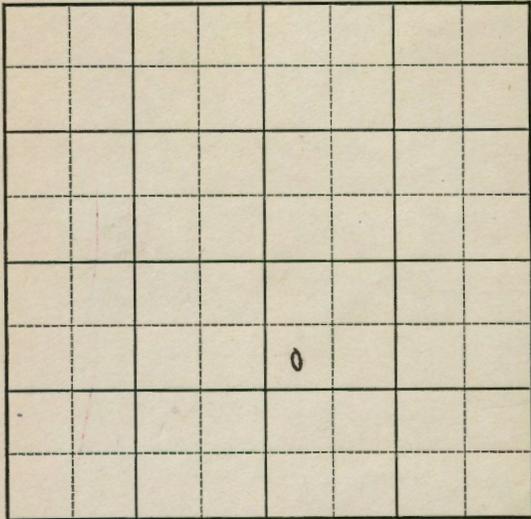

SOUTH

10

FORM 252-A
5M 9-42 GAS

KANSAS

Phillips

Sec. 28 Twp. 5 R. 20-W

Well No. #4 Reece "E" Farm _____

Cities Service Oil Company _____

Ray


990 Ft. from N. Line

_____ Ft. from S. Line

_____ Ft. from E. Line

330 Ft. from W. Line

Elev. 2153

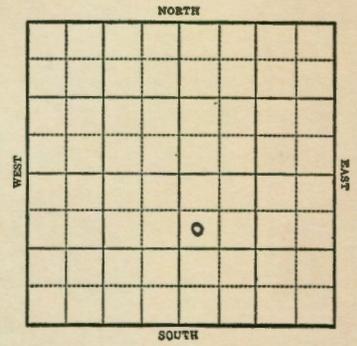

1943

REPORT

6/23

Derrick

6/30

8" @ 153'
Dflg. 3121'

7/7

Arb 3541
T. D. 3632

7/15

5" @ 3632 Rust
Lans 3287
Arb 3539 Corrected
5" @ 3630' T.D.
24 shots 3575-78 2725' oil
53/4 hrs.

7/21

Arb. 3539
5" @ 3630'
Lans 3287
T.D. 3630'
24 shots 3575-88
Echo Pot 2161
Gravity 35

COMPLETED

KANSAS

Map No. 133 Sec. 28 Twp. 5 R. 20W

Well No. 4 Reece "E"

Cities Service Oil Company

COMPLETED Contractor

SW NW SE

SECTION PLAT


990 Ft. from N. Line

Ft. from S. Line

Ft. from E. Line

330 Ft. from W. Line

Ray Pool

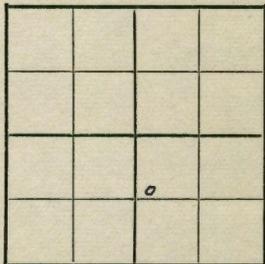

Location

Rig up

Drilling and Remarks:

CR 3589
 5" O 3630
 Lines 3287
 242 h2 to 3595 TT
 Ec 48 R 2161
 35-82

RECORD

Cased in. ft.

Sand

Gas

Oil

Total Depth 3690

PRODUCTION

1st 24 hrs. Nat.

1st 24 hrs. after shot

Gas Cu. Ft.

Dry Hole

Abandoned

Date

JUL 21 1943 19

S. J. LEWIS Scout

KANSAS

Map No. 133 Sec. 28 Twp. 5 R. 20W

Well No. 4 Reece "E"

Cities Service Oil Company

FIRST REPORT Contractor

SW NW SE

SECTION PLAT


990 Ft. from N. Line

Ft. from S. Line

Ft. from E. Line

330 Ft. from W. Line

RAY POOL

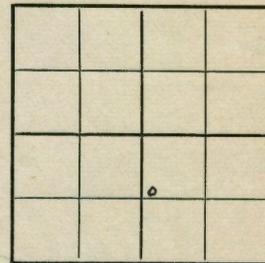

Location

Rig up

Drilling and Remarks:

Der rick

RECORD

Cased in. ft.

Sand

Gas

Oil

Total Depth

PRODUCTION

1st 24 hrs. Nat.

1st 24 hrs. after shot

Gas Cu. Ft.

Dry Hole

Abandoned

Date

JUN 23 1943 19

S. J. LEWIS Scout