


Phillips

Section 28 Township 5 Range 20W

Well No. #5 Reece "E"

Company Cities Service Oil

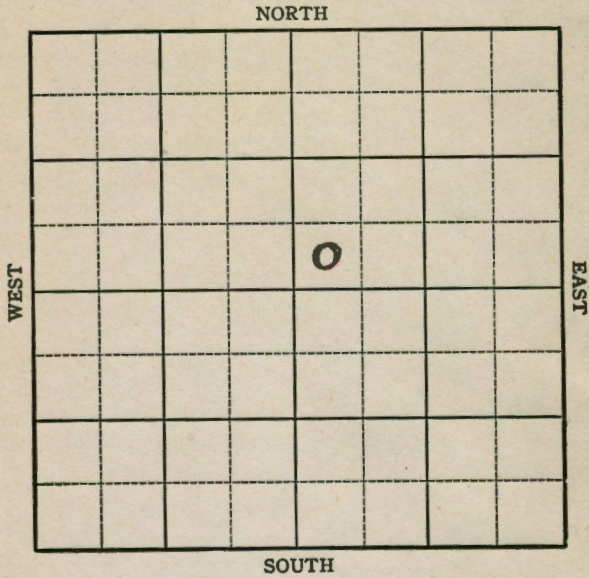

7

Phillips

Sec. 28 Twp. 5 R. 20 W

Well No. #5 Reece "E" Farm \_\_\_\_\_

Cities Service Oil Company \_\_\_\_\_

Ray Pool


\_\_\_\_\_ Ft. from N. Line

330 Ft. from S. Line

\_\_\_\_\_ Ft. from E. Line

330 Ft. from W. Line

*elev. 2187*

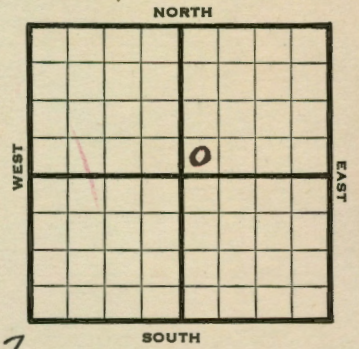

1944

REPORT

4/12 Location

4/19 Derrick

4/26 "

5/3 160' Run Csg.

5/10 8" @ 158  
Drlg. 3488'

5/17 **Lans. 3329**  
**Arb. 3591-95 T.D.**  
5" - 3592 - RUST

5/31 5" @ 2592  
**Arb 3591**  
TD 3608  
Pump 945 Pot  
Grav. 35

**COMPLETED**

**KANSAS**

Pool Name Ray Pool

Map No. 133 Sec. 28 Twp. 5 R. 20W

Well No. 5 Reece "E"

Cities Service Oil Company

**COMPLETED**

Contractor

SW NE

SECTION PLAT

\_\_\_\_\_ Ft. from N. Line

330 Ft. from S. Line

\_\_\_\_\_ Ft. from E. Line

330 Ft. from W. Line

		o	

Phillips County

Location \_\_\_\_\_

Rig up \_\_\_\_\_

Drilling and Remarks:

*See 83591*

*5' @ 3592*

*Pump. 945 P.D.*

*35° 92*

RECORD

Cased \_\_\_\_\_ in., \_\_\_\_\_ ft.

Sand \_\_\_\_\_

Gas \_\_\_\_\_

Oil \_\_\_\_\_

Total Depth 3608

PRODUCTION

1st 24 hrs. Nat. \_\_\_\_\_

1st 24 hrs. after shot \_\_\_\_\_

Gas \_\_\_\_\_ Cu. Ft.

Dry Hole \_\_\_\_\_

Abandoned \_\_\_\_\_

Date

MAY 3 1 1944 19

S. J. LEWIS Scout

**Phillips**

**KANSAS**

Map No. 133 Sec. 28 Twp. 5 R. 20W

Well No. 5 Reece "E"

Cities Service Oil Company

**FIRST REPORT**

Contractor

SW NE

SECTION PLAT

\_\_\_\_\_ Ft. from N. Line

330 Ft. from S. Line

\_\_\_\_\_ Ft. from E. Line

330 Ft. from W. Line

		o	

Ray Pool

Location X

Rig up \_\_\_\_\_

Drilling and Remarks:

RECORD

Cased \_\_\_\_\_ in., \_\_\_\_\_ ft.

Sand \_\_\_\_\_

Gas \_\_\_\_\_

Oil \_\_\_\_\_

Total Depth \_\_\_\_\_

PRODUCTION

1st 24 hrs. Nat. \_\_\_\_\_

1st 24 hrs. after shot \_\_\_\_\_

Gas \_\_\_\_\_ Cu. Ft.

Dry Hole \_\_\_\_\_

Abandoned \_\_\_\_\_

Date

APR 1 2 1944 19

S. J. LEWIS Scout