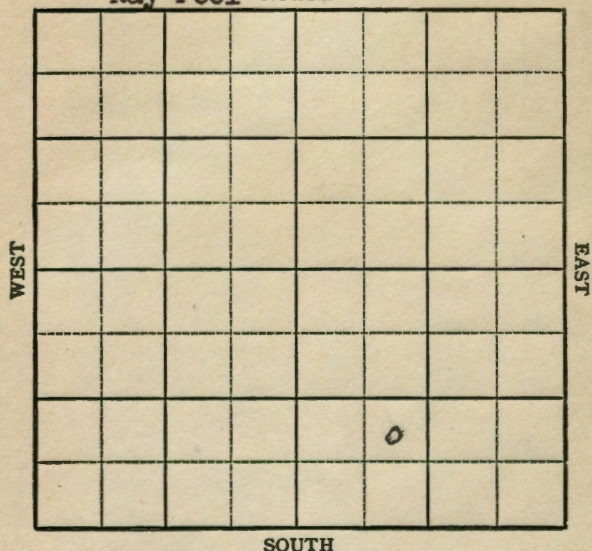


KANSAS

Section 28 Township 5 Range 20-WWell No. #9 Reese "E"Company Cities ServicePhillips CountyRay Pool NORTH

SOUTH

EAST

WEST

5M 10-48 PETROL

KANSAS

Phillips

Sec. 28 Twp. 5 R. 20WWell No. #9 Reese "E" Farm

Cities Service

Company

Ray Pool


Ft. from N. Line

990' Ft. from S. Line

Ft. from E. Line

990' Ft. from W. Line

NE SW SE

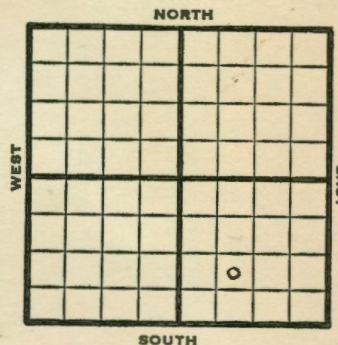

1948 Elev. 2166' REPORT

12/8 8" @ 189'  
Drlg. 3058'

12/15 Arb 3570'  
Reagan 3588'  
TD 3603'  
5" @ 3603'  
12/22 33 shots 3581-90  
Pump 231 bbls oil 11 hrs.

12/29 12 shots 3590-92  
48 shots 3569-72 1000 acid  
Pump 100 bbls oil 6 hrs.  
Lansing 3305'  
Gorham 3565

1949

1/5

Arb 3570'  
Reagan 3588'  
5" @ 3603'  
Perf Arb.  
1000 acid  
Echo Pot. 2960 oil  
Grv. 29°  
TD 3603'

COMPLETED

15

Kansas

Map No. 133 Sec. 28 Twp. 5 R. 20W  
 Well No. 9 Reese "E"


Cities Service Company

COMPLETE

Contractor

NE SW SE

SECTION PLAT

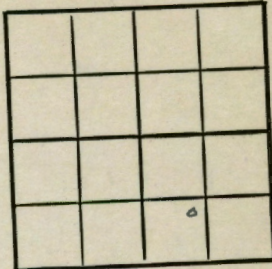

Ft. from N. Line

990

Ft. from S. Line

Ft. from E. Line

990

Ft. from W. Line

Phillips County

Location

Rig up

Drilling and Remarks:

*Oct 30 1948**Reagan 3588**5" 13663**Pay 1000000**Echid 2960 oil**2924*

## RECORD

Cased in, ft.

Sand

Gas

Oil

Total Depth *3663*

## PRODUCTION

1st 24 hrs. Nat.

1st 24 hrs. after shot

Gas Cu. Ft.

Dry Hole

Abandoned

Date

JAN 5

1949

19

S. J. LEWIS

Scout

Kansas

Map No. \_\_\_\_\_ Sec. 28 Twp. 5 R. 20W  
 Well No. 9 Reese "E"


Cities Service Company

FIRST REPORT

Contractor

NE SW SE

SECTION PLAT

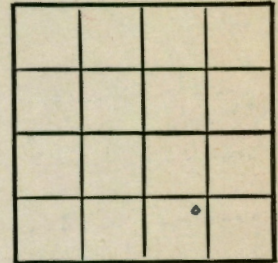

Ft. from N. Line

990

Ft. from S. Line

Ft. from E. Line

990

Ft. from W. Line

Phillips County

Location

Rig up

Drilling and Remarks:

8" @ 189

drlg. 3058

## RECORD

Cased in, ft.

Sand

Gas

Oil

Total Depth

## PRODUCTION

1st 24 hrs. Nat.

1st 24 hrs. after shot

Gas Cu. Ft.

Dry Hole

Abandoned

Date

DEC 8

1948

19

S. J. LEWIS

Scout