


KANSAS

Phillips

Section 28 Township 5 Range 20W
 Well No. 10 Reese "E"
 Company Cities Service

Ray

NORTH

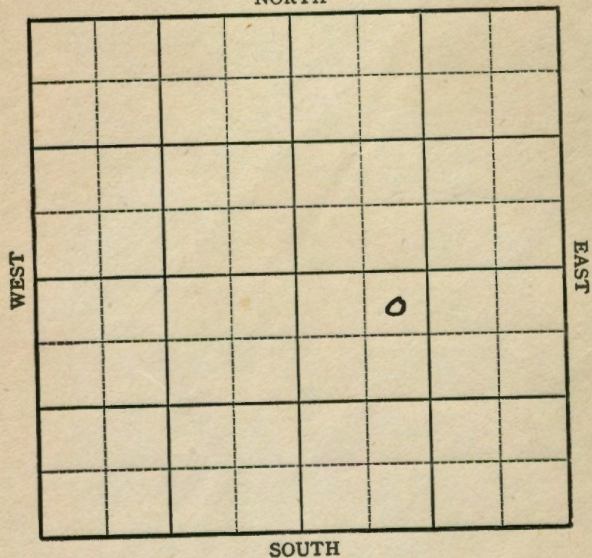

SOUTH

KANSAS

Phillips

Sec. 28 Twp. 5 R. 20W

Well No. #10 Reese "E" Farm
Cities Service Company

Ray Pool


30' Ft. from N. Line

Ft. from S. Line

Ft. from E. Line

990' Ft. from W. Line

NE NW SE

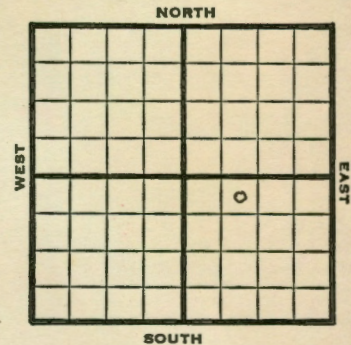

1949

Elev 2180'

REPORT

1/19

Location

1/26

8" @ 196'

Drlg 3198'

2/2

Lansing 3317'

BKC 3524'

Arbuckle 3569'

TD 3625'

5" @ 3625'

2/9

"

2/16

TD 3625'

2/23

Arb. 3569'

Reagan 3617'

5" @ 3625'

Perf Arb.

90 shots 3567-90

1500 acid

Depth Pot 1727 Oil

30° r.

Comp

COMPLETED

Map No. K/33 Sec. 28 Twp. 5 R. 20W

Well No. 10 Reese "E"

Cities Service Company

COMPLETE

Contractor

NE NW SE

SECTION PLAT

330 Ft. from N. Line

Ft. from S. Line

Ft. from E. Line

990 Ft. from W. Line

Phillips County

Location

Rig up

Drilling and Remarks:

Cur 3569
Reagan 3617
Q 3625
Cur 3625
9000000
Dep to 1727
300000

Date

FEB 23 1949

RECORD

Cased in. ft.

Sand

Gas

Oil

Total Depth 3625

PRODUCTION

1st 24 hrs. Nat.

1st 24 hrs. after shot

Gas Cu. Ft.

Dry Hole

Abandoned

S. J. LEWIS Scout

Map No. Sec. 28 Twp. 5 R. 20W

Well No. 10 Reese "E"

Cities Service Company

FIRST REPORT

Contractor

NE NW SE

SECTION PLAT

330 Ft. from N. Line

Ft. from S. Line

Ft. from E. Line

990 Ft. from W. Line

Phillips County

Location X

Rig up

Drilling and Remarks:

RECORD

Cased in. ft.

Sand

Gas

Oil

Total Depth

PRODUCTION

1st 24 hrs. Nat.

1st 24 hrs. after shot

Gas Cu. Ft.

Dry Hole

Abandoned

Date

JAN 19 1949

S. J. LEWIS Scout