



FORM 51 25M 3-49 PETROL Phillips **KANSAS**  
 Section 28- Township 5 Range 20W  
 Well No. #11 Reese "E"  
 Company Cities Service Oil

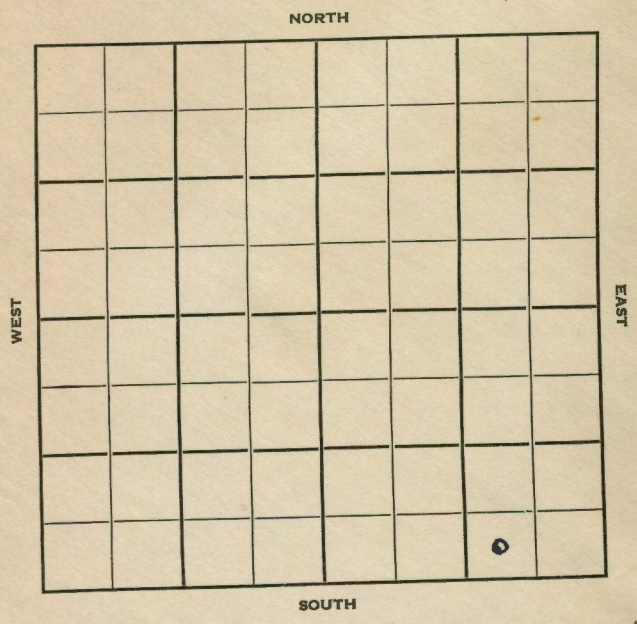

16

FORM 252-B Phillips **KANSAS** ✓  
 10M 8-51 TPCO.  
 Sec. 28 Twp. 5 R. 20 W  
 Well No. # 11 Reese "E" Farm  
Cities Service Oil Company  
Rine Drlg. Contractor  
Ray Pool  
 ..... Ft. from N. Line  
330 ..... Ft. from S. Line  
990 ..... Ft. from E. Line  
 ..... Ft. from W. Line  
 SW SE SE

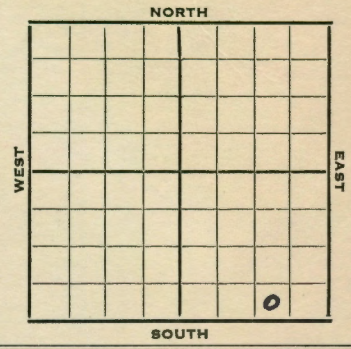

1952	Elev. 2169'	REPORT
10/15	Spud 10-12-52 8" @ 195 Drlg. 634'	
10/22	Drlg. 3570'	
10/29	Heeb 3279' Dodge 3303' Lans. 3319' B KC 3523' Gorham 3577' Arb. 3583' 5" @ 3584 RTD 3584'	
11/5	NR	
11/12	DD Reagan 3591 FU 3480' fluid 14 hrs. P/ 115 BO & 10 BW 14 hrs.	
11/20	TD 3594'	
11/27	"	
12/4	NR	
12/11	NR	
12/17	Spud 10-12-52 Oil Well TD 3594 8" @ 195 Heeb 3279, Dodge 3303, Lans 3319 B KC 3523, Gorham 3577, Arb 3583 5" @ 3584 TD 3584 DD Regan 3591 FU 3480' fluid 14 hrs. P. 115 bo 10 bw 14 hrs., DD 3594	<b>OVER</b>

(Information Brought Forward)

1952

12/17 Comp. 131 bopd 1% wtr.

**COMPLETED**

