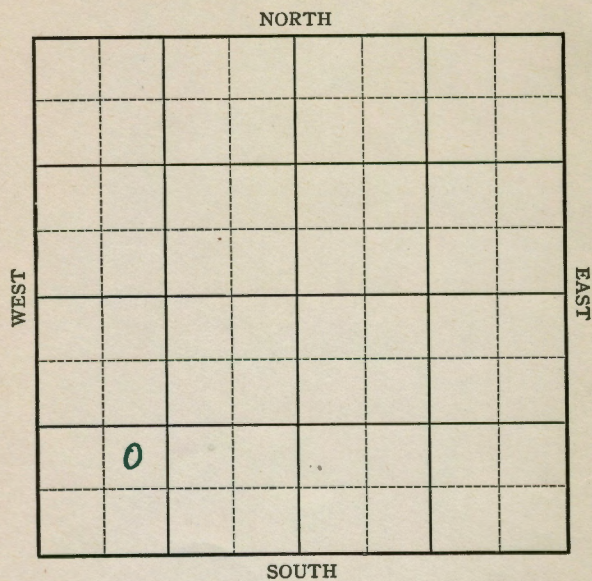


Phillips

KANSAS

Section 28 Township 5 Range 20WWell No. #2 VehigeCompany Cities Service Oil

13

KANSAS

Phillips

Sec. 28 Twp. 5 R. 20-WWell No. #2 Vehige Farm
Cities Service Oil Company
 (Ray)


Ft. from N. Line

990 Ft. from S. Line

Ft. from E. Line

990 Ft. from W. Line

Elev. 2190

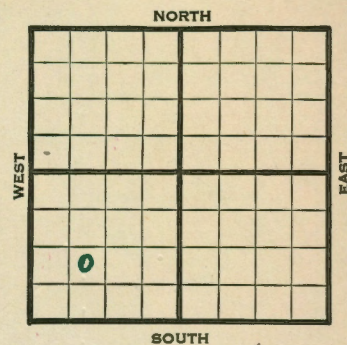

1941	REPORT
7/16	8" - 150' WOC.
7/24	Drig. 3570'
7/31	Lansing 3325 BKC 2540
	Arb 3583-84
	TD 5" @ 3584' RUST
8/7	TD 3595' 1000 acid Echo Test
	6793' oil 8000 water PB.
8/15	" " " " "
8/21	P.B. to 3585' WOC.
8/28	" " " "
9/4	Pump 25 oil & 25 water.
9/11	Pump 212 fluid, 70% water.
	Shut down.
9/18	" "
9/25	" "
10/2	P.B. to 3589' 500 acid.
10/9	20 shots 3584-89'
	Jet 2000 acid.
10/16	T.D. 3591' Testing.
10/23	" " "
10/30	Pump 223 oil & 17 water 19 hrs.
11/6	" " " " OVER

1941

11/13 Pump 223 oil & 17 water in 19
hours.

11/20 " " "

11/26 " " "

12/4 " " "

12/11 " " "

12/17 Lans. 3325'

Arb. 3583'

5" - 3584'

T.D. 3595'

P.B. to 3591'

4000 acid.

Potential 250 bbls., pump.

35. Gravity

COMPLETED

Phillips

KANSAS

Map No. 133 Sec. 28 Twp. 5 R. 20WWell No. 2 Vehige

Cities Service Oil Company

~~COMPLETED~~

Contractor

NE SW SW

SECTION PLAT

Ft. from N. Line

990 Ft. from S. Line

Ft. from E. Line

990 Ft. from W. Line

RAY POOL

Location

Rig up

Drilling and Remarks:

Ham 8325
Alt 8583
5" @ 3584
PB 3591
4000 acid
Pump 250 P.D.
352 Gd.

RECORD

Cased in, ft.

Sand

Gas

Oil

Total Depth 3595

PRODUCTION

1st 24 hrs. Nat.

1st 24 hrs. after shot

Gas Cu. Ft.

Dry Hole

Abandoned

Date

DEC 17 1941 19

S. J. LEWIS

Scout

Phillips

KANSAS

Map No. 133 Sec. 28 Twp. 5 R. 20WWell No. 2 Vehige

Cities Service Oil Company

Contractor

FIRST REPORT

SECTION PLAT

NE SW SW

Ft. from N. Line

990 Ft. from S. Line

Ft. from E. Line

990 Ft. from W. Line

RAY POOL

Location

Rig up

Drilling and Remarks:

8" - 150 WOC

RECORD

Cased in, ft.

Sand

Gas

Oil

Total Depth

PRODUCTION

1st 24 hrs. Nat.

1st 24 hrs. after shot

Gas Cu. Ft.

Dry Hole

Abandoned

Date

JUL 16 1941 19

S. J. LEWIS

Scout