

KANSAS


Phillips

FORM 51 5M 4-41 PETROL

Section 28 Township 5 Range 20-W
 Well No. #3 Vehige
 Company Cities Service Oil

NORTH

Ray Pool

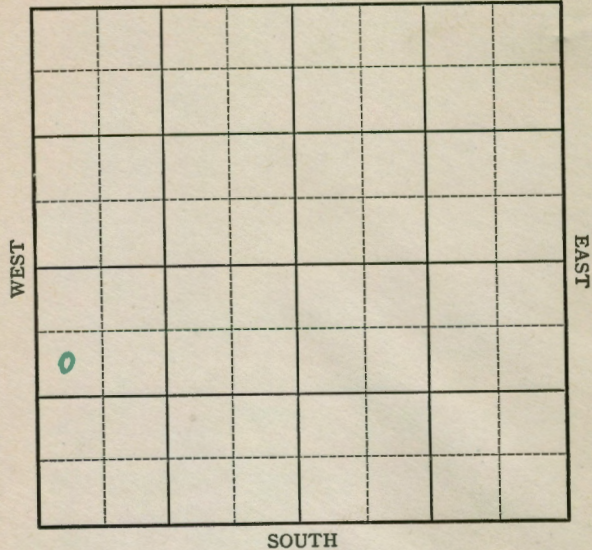

12

FORM 252-A 5M 6-41 PETROL

KANSAS

Phillips

Sec. 28 Twp. 5 R. 20-W
 Well No. #3 Vehige Farm _____
 Cities Service Oil Company _____

(Ray)


990 Ft. from N. Line

Ft. from S. Line

Ft. from E. Line

330 Ft. from W. Line

Elev. 2186

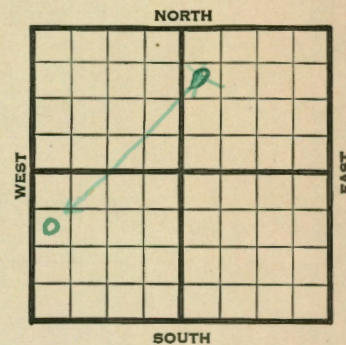

1942	REPORT
5/20	Surface hole.
5/27	8" - 165' Drlg. 3072'
6/3	Lans. 3329' No Arb. Reagan ³⁶⁰² 3613' Granite 3663' T.D. 3664' show water.
	Shut down.
6/10	" "
6/17	5" - 3664' RUST.
6/24	Reagan 3602' (Corrected)
	5" - 3664'
	T.D. 3664'
	12 shots 3602-06'
	Echometer potential 1819 bbls.
	35. Gravity
	COMPLETED

Phillips

KANSAS

Map No. 133 Sec. 28 Twp. 5 R. 20WWell No. 3 Vehige

Cities Service Oil Company

COMPLETED

Contractor

SW NW SW

SECTION PLAT

990 Ft. from N. Line

_____ Ft. from S. Line

_____ Ft. from E. Line

330 Ft. from W. Line

0			

RAY POOL

Location _____

Rig up _____

Drilling and Remarks:

*Reagan 3602 Cor**5" @ 3664**12 Sh to 3602-06**Echo Rd. 1819**35° 44'*

RECORD

Cased _____ in., _____ ft.

Sand _____

Gas _____

Oil _____

Total Depth *3664*

PRODUCTION

1st 24 hrs. Nat. _____

1st 24 hrs. after shot _____

Gas _____ Cu. Ft.

Dry Hole _____

Abandoned _____

Date

JUN 24 1942 19S. J. LEWIS Scout

Map No. 133 Sec. 28 Twp. 5 R. 20WWell No. 3 VehigeCities Service Oil CompanyCORRECTION Contractor

SW NW SW

990 Ft. from N. Line

Ft. from S. Line

Ft. from E. Line

330 Ft. from W. Line

SECTION PLAT

0			

RAY POOL

Location

Rig up

Drilling and Remarks:

Reported

SW NW NE

RECORD

Cased in, ft.

Sand

Gas

Oil

Total Depth

PRODUCTION

1st 24 hrs. Nat.

1st 24 hrs. after shot

Gas Cu. Ft.

Dry Hole

Abandoned

Date

MAY 23 1942 19S. J. LEWIS ScoutMap No. 133 Sec. 28 Twp. 5 R. 20WWell No. 3 VehigeCities Service Oil CompanyFIRST REPORT Contractor

SW NW NE

990 Ft. from N. Line

Ft. from S. Line

Ft. from E. Line

330 Ft. from W. Line

SECTION PLAT

		0	

RAY POOL

Location

Rig up

Drilling and Remarks:

Surface Hole

RECORD

Cased in, ft.

Sand

Gas

Oil

Total Depth

PRODUCTION

1st 24 hrs. Nat.

1st 24 hrs. after shot

Gas Cu. Ft.

Dry Hole

Abandoned

Date

MAY 20 1942 19S. J. LEWIS Scout

Sandy:

Don't think the Engineering Dept will accept this ticket as it is. #1 & #2 are in SW 40 ac. of SW/4 while #3 is in NE/4. Is this location OK?

Don Schumaker

This is correct

890 Ft. from N. Line
Ft. from S. Line
Ft. from E. Line
330 Ft. from W. Line

RAY POOL

RECORD

Location
Rig up
Drilling and Remarks
Oil

Misc. Small Maps

Cards

Tracing

France Map

Scarborough Map

Moody Map

Geological Dept.

Moody Plat Book

Date

MAY 20 1942