

KANSAS


FORM 51 5M PETROL

Phillips

Section 28 Township 5 Range 20-W

Well No. #1 Vehige "B"

Company Cities Service Oil

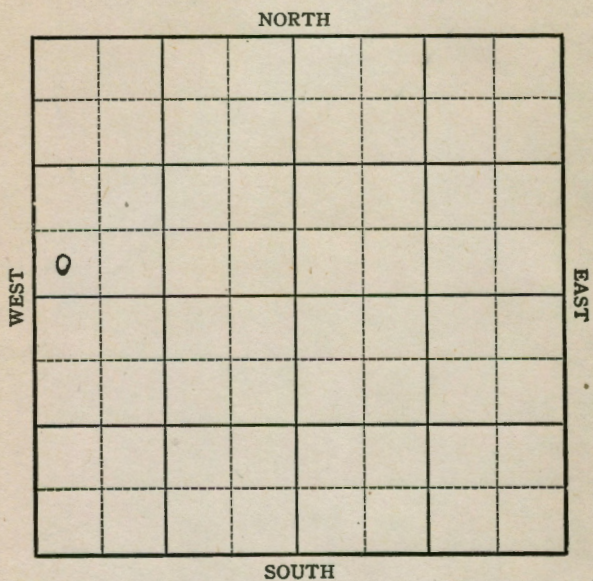

FORM 252-A
5M 9-43 GASS

KANSAS

Phillips

Sec. 28 Twp. 5 R. 20-W

Well No. #1 Vehige "B" Farm _____


Cities Service Oil Company _____

_____ Ft. from N. Line

330 Ft. from S. Line

_____ Ft. from E. Line

330 Ft. from W. Line

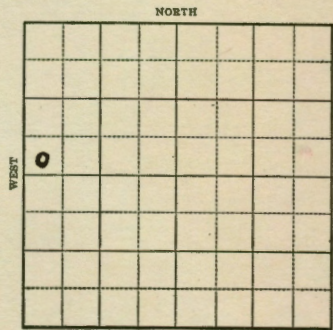

ELEV. 2201

1943

R E P O R T

9/8 8" @ 165'

W.O.C.

9/15 Drlg. 3328'

9/22 Drlg. 3655'

9/29 **Lans 3327**
Reagan 3618

T.D. 3675

5" @ 3675'

Rust

10/6 **Reagan 3618**

5" @ 3675

24 shots 3630-34

Echo Pot 1903

Gravity 36.4

T.D. 3675'

COMPLETED

KANSAS

Map No. 133 Sec. 28 Twp. 5 R. 20W

Well No. 1 Vehige "B"

Cities Service Oil Company

COMPLETED Contractor

SW NW

SECTION PLAT

Ft. from N. Line

330 Ft. from S. Line

Ft. from E. Line

330 Ft. from W. Line

Ray Pool

Location _____

Rig up _____

Drilling and Remarks:

*Reagan 3618
5 @ 3675
24 hrs to 3630-34
Echo Box 1943*

36 1/2

RECORD

Cased _____ in., _____ ft.

Sand _____

Gas _____

Oil _____

Total Depth 3675

PRODUCTION

1st 24 hrs. Nat. _____

1st 24 hrs. after shot _____

Gas _____ Cu. Ft.

Dry Hole _____

Abandoned _____

Date

OCT 6 1943 19

S. J. LEWIS Scout

KANSAS

Map No. 133 Sec. 28 Twp. 5 R. 20W

Well No. 1 Vehige "B"

Cities Service Oil Company

FIRST REPORT Contractor

SW NW

SECTION PLAT

Ft. from N. Line

330 Ft. from S. Line

Ft. from E. Line

330 Ft. from W. Line

Ray Pool

Location _____

Rig up _____

Drilling and Remarks:

8" - 165
WOC

RECORD

Cased _____ in., _____ ft.

Sand _____

Gas _____

Oil _____

Total Depth _____

PRODUCTION

1st 24 hrs. Nat. _____

1st 24 hrs. after shot _____

Gas _____ Cu. Ft.

Dry Hole _____

Abandoned _____

Date

SEP 8 1943 19

S. J. LEWIS Scout