


Section 28 Township 5 Range 20 W

Well No. # 3 Vehige "B"

Company Cities Service

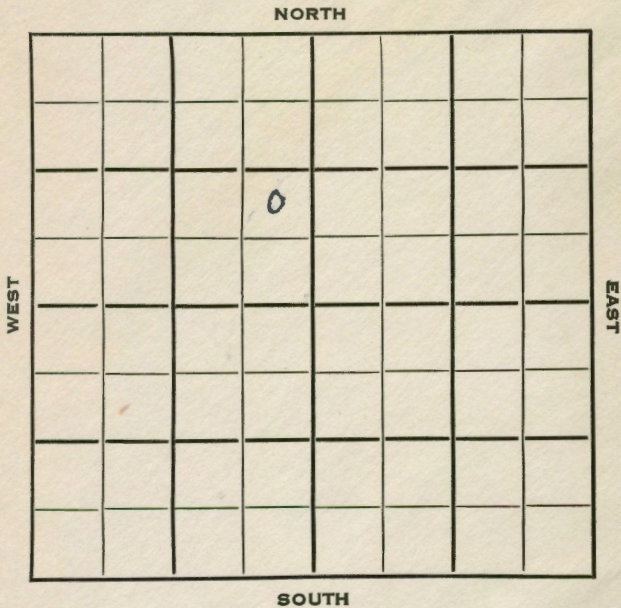

6


SEC. 28 TWP. 5 R. 20W ✓

WELL NO. #3 Vehige "B" FARM

COMPANY Cities Service

CONTRACTOR Rine Drlg.

Ray Pool

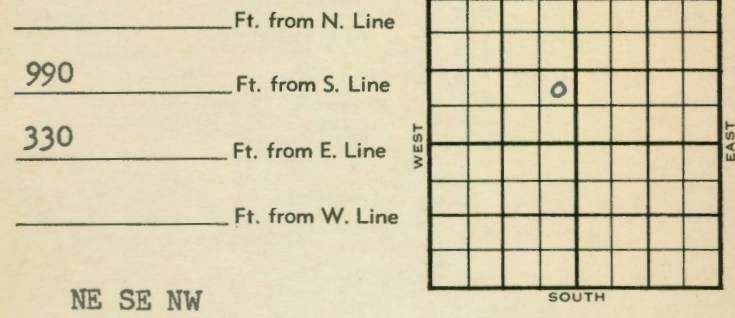

_____ Ft. from N. Line

990 _____ Ft. from S. Line

330 _____ Ft. from E. Line

_____ Ft. from W. Line

NE SE NW

	ELEVATION	REPORT
1953	2200'	

10/14	Spud 10-12-53 8" @ 207' WOC	
10/21	WOC	
10/28	Heeb 3317' Dodge 3343' Lans 3358 DST 3344-72, 1 hr, 10' M DST 3431-55, 1 hr, 12' M 1050# DST 3538-63, 1 hr, 10' M 120# Gorham 3601' Arb. 3604' RTD 3609' 5" @ 3605'	
11/4	DD 3612' TD FU 1400' oil 24 hrs. P/44 BO & 1 BW 24 hrs.	
11/11	NR	
11/18	NR	
12/9	Spud 10-12-53 Oil well TD 3612' 8" @ 207' Heeb 3317' Dodge 3343' Lans. 3358' DST 3344-72 open 1 hr rec 10' mud. DST 3431-55 open 1 hr rec 12' mud 1050# DST 3538-63 open 1 hr rec 10' mud 120# Gorham 3601' Arb. 3604' TD 3609 5" @ 3605 DD 3612' FU 1400' oil 20 hr. P/44 BO 1 BW 24 hrs. 500 A Comp. 99 BOPD COMPLETED	

