

KANSAS


Form 51-5M-7-40-Palace

Phillips

Section 29 Township 5 Range 20-W

Well No. 1 Noel

Company Cities Service Oil

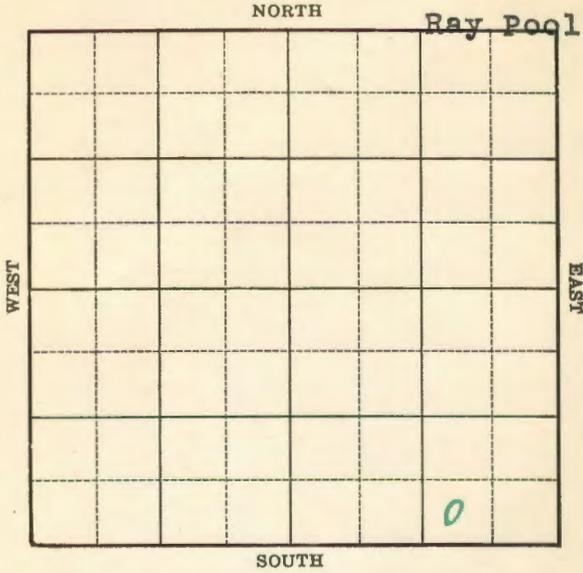

FORM 252-A 5M 2-40

KANSAS

Phillips

Sec. 29 Twp. 5 R. 20-W

Well No. #1 Noel Farm

Cities Service Oil Company

(Ray)


Ft. from N. Line

308 Ft. from S. Line

990 Ft. from E. Line

Ft. from W. Line

Elev. 2185

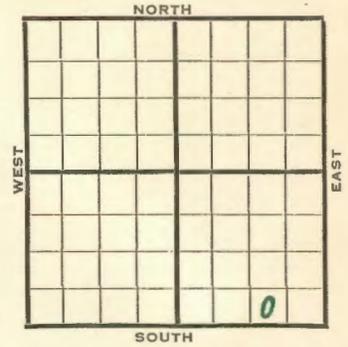

REPORT	
1941	
1/15	Rotary.
1/23	10" - 155' Drlg. 2473'
1/30	Arb. 3583-87' ³⁵⁸³ T.D. 5" - 3584' ³⁵⁸³
	RUST. Sat.
2/6	Topeka 2915' Lans. 3330'
	B.K.C. 3545'
	Arb. 3583' (Corrected)
	5" - 3583' 3591' - 400' oil.
	Reagan 3591' T.D. 3602'
	2900' oil 13½ hours.
	Shut down.
2/13	Echometer potential 3000 - plus
2/19	Arb. 3583'
	5" - 3583'
	Reagan 3591'
	T.D. 3602'
	Echometer potential 3065 bbls.
	Maximum 3000 bbls.
	33. Gravity
	COMPLETED

Map No. 133 Sec. 29 Twp. 5 R. 20W

Well No. 1 Noel
Cities Service Oil Company

COMPLETED Contractor

SW SE SE

SECTION PLAT

_____ Ft. from N. Line
308 Ft. from S. Line
990 Ft. from E. Line
_____ Ft. from W. Line

RAY POOL

Location _____

RECORD

Cased _____ in., _____ ft.
Sand _____
Gas _____
Oil _____
Total Depth 3602

Rig up _____
Drilling and Remarks:

Cu 3583
5" 3573
Reagan 3591
Echd P 3065
Mo 3000
33e 98

PRODUCTION

1st 24 hrs. Nat. _____
1st 24 hrs. after shot _____
Gas _____ Cu. Ft.
Dry Hole _____
Abandoned _____

Date

FEB 19 1941 19 S. J. LEWIS Scout

Map No. 133 Sec. 29 Twp. 5 R. 20W

Well No. 1 Noel
Cities Service Oil Company

Contractor

FIRST REPORT

SW SE SE

SECTION PLAT

_____ Ft. from N. Line
308 Ft. from S. Line
990 Ft. from E. Line
_____ Ft. from W. Line

RAY POOL

Location _____

RECORD

Cased _____ in., _____ ft.
Sand _____
Gas _____
Oil _____
Total Depth _____

Rig up _____
Drilling and Remarks:

Rotary

PRODUCTION

1st 24 hrs. Nat. _____
1st 24 hrs. after shot _____
Gas _____ Cu. Ft.
Dry Hole _____
Abandoned _____

Date

JAN 15 1941 19 S. J. LEWIS Scout