KANSAS


FORM 51 5M 4-41 PETROL

Phillips

Section 29 Township 5 Range 20-W

Well No. ~~#~~3~~=~~ Pinkerton ~~"B"~~ "A"

Company Cities Service Oil

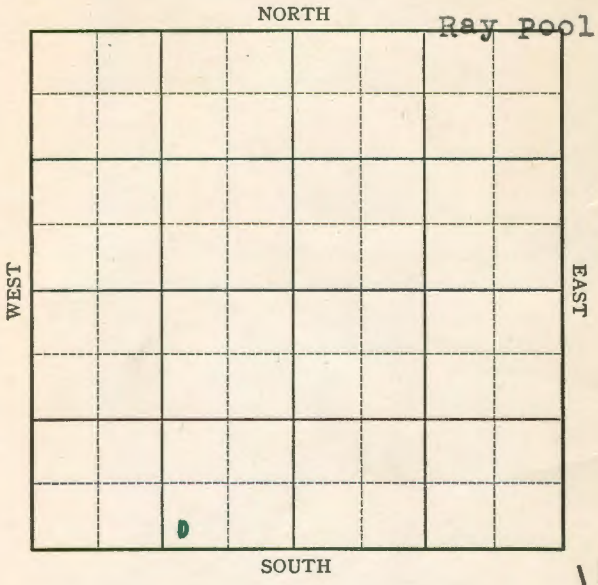

14

FORM 252-A 5M 6-41 PETROL KANSAS Phillips

Sec. ~~29~~ 29 Twp. 5 R. 20-W

Well No. ~~#1~~ Pinkerton ~~"B"~~ #3-"A" Farm

Cities Service Oil Company


(Ray)

____ Ft. from N. Line

330 Ft. from S. Line

990 Ft. from E. Line

____ Ft. from W. Line

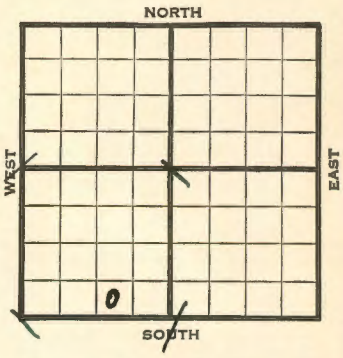

1941	REPORT
9/17	8" - 160'
	Drlg. 950'
9/25	Arb. 3619-21' T.D. 5" - 3621'
	RUST.
10/2	"
10/8	Reagan 3628'
	5" - 3621'
	T.D. 3634'
	Echometer potential 3966 bbls.
	Maximum 3000 bbls.
	35. Gravity
	COMPLETED

m 26 200 Bks. 5-41 McW. Phillips KANSAS

Map No. ____ Sec. 29 Twp. 5 R. 20W

Well No. 3 Pinkerton "A"

Cities Service Oil Company

CORRECTION Contractor

SECTION PLAT

SW SE SW

____ Ft. from N. Line

330 Ft. from S. Line

990 Ft. from E. Line

____ Ft. from W. Line

RAY POOL

Location

Rig up

Drilling and Remarks:
Changed from
1 Pinkerton "B"

RECORD

Cased ____ in., ____ ft.

Sand

Gas

Oil

Total Depth

PRODUCTION

1st 24 hrs. Nat.

1st 24 hrs. after shot

Gas ____ Cu. Ft.

Dry Hole

Abandoned

Date

OCT 8 1941 19 S. J. LEWIS Scout

For: Bks. 5-41 McW. Phillips KANSAS

Map No. K-133 Sec. 29 Twp. 5 R. 20W

Well No. 3 Pinkerton "A"

Cities Service Oil Company

COMPLETED Contractor

SECTION PLAT

SW SE SW

____ Ft. from N. Line

330 Ft. from S. Line

990 Ft. from E. Line

____ Ft. from W. Line

RAY POOL

Location

Rig up

Drilling and Remarks:
Reagan 3628.
SO 3624
Echo Pay 3966
Miss 3000

33-0 Gr

RECORD

Cased ____ in., ____ ft.

Sand

Gas

Oil

Total Depth 3634

PRODUCTION

1st 24 hrs. Nat.

1st 24 hrs. after shot

Gas ____ Cu. Ft.

Dry Hole

Abandoned

Date

OCT 8 1941 19 S. J. LEWIS Scout

Form 26 200 Bks. 5-41 McW. Phillips KANSAS


Map No. 133 Sec. 29 Twp. 5 R. 20W

Well No. 1 Pinkerton "B"

Cities Service Oil Company

~~FIRST REPORT~~ Contractor

SECTION PLAT

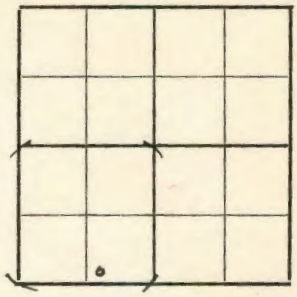

SW SE SW

Ft. from N. Line

330 Ft. from S. Line

990 Ft. from E. Line

Ft. from W. Line

RAY POOL

Location

Rig up

Drilling and Remarks:

8" @ 160

Drilling 950'

RECORD

Cased in., ft.

Sand

Gas

Oil

Total Depth

PRODUCTION

1st 24 hrs. Nat.

1st 24 hrs. after shot

Gas Cu. Ft.

Dry Hole

Abandoned

Date

SEP 17 1941 19

S. J. LEWIS Scout

Form 26 200 Bks. 5-41 McW. Phillips KANSAS

Map No. 133 Sec. 29 Twp. 5 R. 20W

Well No. 1 Pinkerton "B"

Cities Service Oil Company

~~FIRST REPORT~~ Contractor

SW SE SW

Ft. from N. Line


330 Ft. from S. Line

990 Ft. from E. Line

Ft. from W. Line

RAY POOL

SECTION PLAT

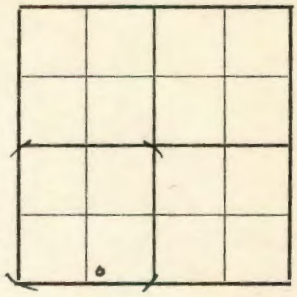

Location

Rig up

Drilling and Remarks:

8" @ 160

Drilling 950'

RECORD

Cased in., ft.

Sand

Gas

Oil

Total Depth

PRODUCTION

1st 24 hrs. Nat.

1st 24 hrs. after shot

Gas Cu. Ft.

Dry Hole

Abandoned

Date

SEP 17 1941 19

S. J. LEWIS Scout