


Form 26 200 Bks. 5-41 McW. Phillips **KANSAS**
Map No. 133 Sec. 29 Twp. 5 R. 20W

Well No. 6 Pinkerton
Cities Service Oil Company
FIRST REPORT Contractor

SW/C
_____ Ft. from N. Line
330 Ft. from S. Line
_____ Ft. from E. Line
330 Ft. from W. Line

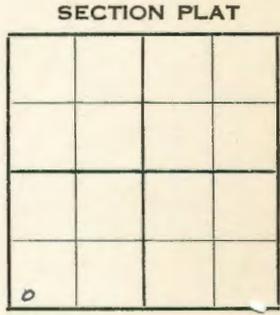

RAY POOL

Location _____
Rig up _____
Drilling and Remarks:

8" - 153'
Waiting on
cement to set

RECORD
Cased _____ in., _____ ft.
Sand _____
Gas _____
Oil _____
Total Depth _____


PRODUCTION
1st 24 hrs. Nat. _____
1st 24 hrs. after shot _____
Gas _____ Cu. Ft.
Dry Hole _____
Abandoned _____

Date
APR 22 1942 19 _____ S. J. LEWIS Scout

Form 26 200 Bks. 5-41 McW. Phillips **KANSAS**
Map No. 133 Sec. 29 Twp. 5 R. 20W

Well No. 6 Pinkerton
Cities Service Oil Company
COMPLETED Contractor

SN/C
_____ Ft. from N. Line
330 Ft. from S. Line
_____ Ft. from E. Line
330 Ft. from W. Line

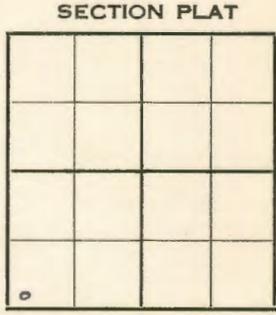

RAY POOL

Location _____
Rig up _____
Drilling and Remarks:
Reagan 8097
5" @ 3595
Echo P 2787

35-9 1/2

RECORD
Cased _____ in., _____ ft.
Sand _____
Gas _____
Oil _____
Total Depth 3604

PRODUCTION
1st 24 hrs. Nat. _____
1st 24 hrs. after shot _____
Gas _____ Cu. Ft.
Dry Hole _____
Abandoned _____

Date
MAY 13 1942 19 _____ S. J. LEWIS Scout