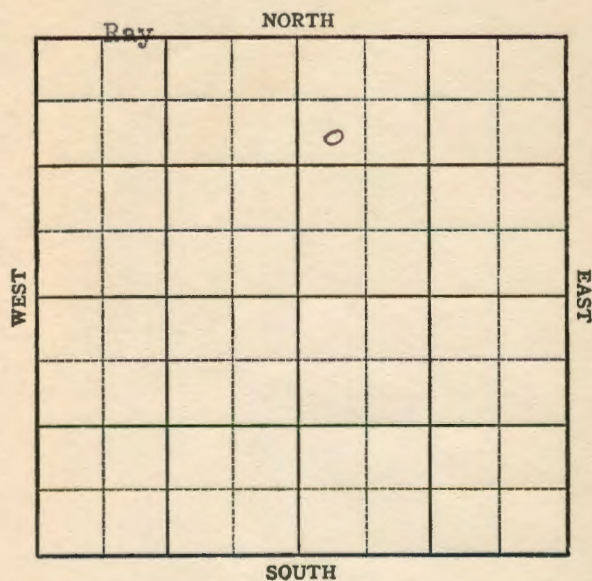


Section 29 Township 5 Range 20WWell No. 3 Reese "D"Company Cities ServiceSec. 29 Twp. 5 R. 20WWell No. #3 Reese "D" Farm

Cities Service Company

Ray


990 Ft. from N. Line

Ft. from S. Line

Ft. from E. Line

330 Ft. from W. Line

SW NW NE

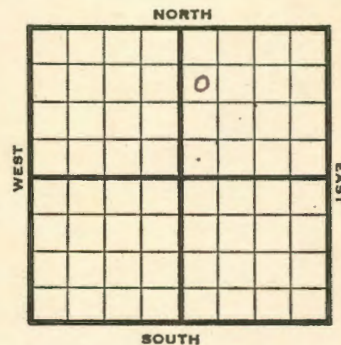

1947

Elev. 2193' REPORT

8/27

8" @ 199'
Drlg. 1700'

9/3

" 3598'

9/10

Lansing 3373'

BKC 3564'

Reagan 3623'

TD 3632'

5" @ 3622'

1500' oil 1-1/2 hrs.

9/17

Reagan 3623'

5" @ 3622'

Pump 308 oil & 21% W Pot.

Gravity 27°

Total Depth 3632'

COMPLETED

Map No. 133 Sec. 29 Twp. 5 R. 20WWell No. 3 Reese "D"

Cities Service

Company

COMPLETE

Contractor


SW NW NE

SECTION PLAT

990 Ft. from N. Line

Ft. from S. Line

Ft. from E. Line

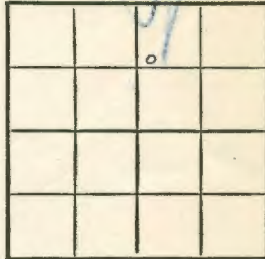330 Ft. from W. Line

Phillips County

Location

Rig up

Drilling and Remarks:

Reaper 8623
5' 0" 8622
Pump 808 mil
7 1/2% N.D.T.

27 2 94

RECORD

Cased in, ft.

Sand

Gas

Oil

Total Depth *1700*

PRODUCTION

1st 24 hrs. Nat.

1st 24 hrs. after shot

Gas Cu. Ft.

Dry Hole

Abandoned

Date

SEP 17 1947 19 S. J. LEWIS Scout

Map No. _____ Sec. 29 Twp. 5 R. 20WWell No. 3 Reese "D"

Cities Service

Company

FIRST REPORT

Contractor


SW NW NE

SECTION PLAT

990 Ft. from N. Line

Ft. from S. Line

Ft. from E. Line

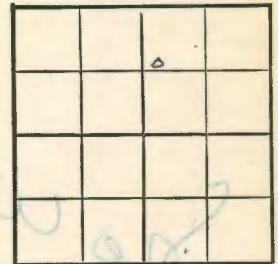330 Ft. from W. Line

Phillips County

Location

Rig up

Drilling and Remarks:

8" @ 199

drlg. 1700

RECORD

Cased in, ft.

Sand

Gas

Oil

Total Depth

PRODUCTION

1st 24 hrs. Nat.

1st 24 hrs. after shot

Gas Cu. Ft.

Dry Hole

Abandoned

Date

AUG 27 1947 19 S. J. LEWIS Scout