


Section 29 Township 5 Range 20-W

Well No. #1 Reese "D"

Company Cities Service Oil

Ray Pool

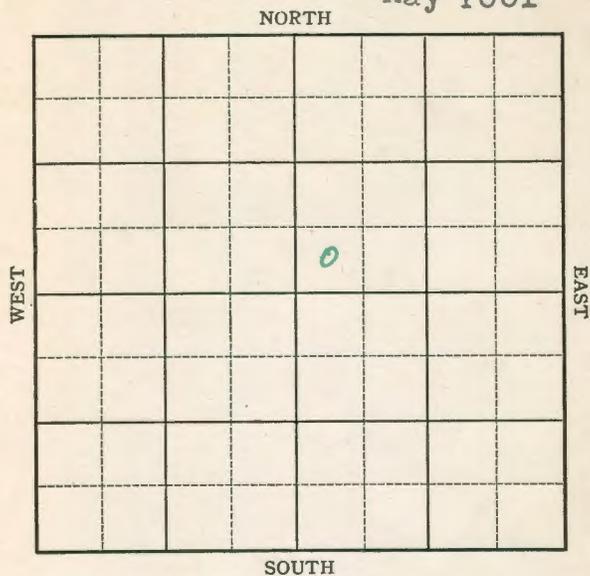

7

Sec. 29 Twp. 5 R. 20-W

Well No. #1 Reese "D" Farm _____

Cities Service Oil Company _____

(Ray)


_____ Ft. from N. Line

330 Ft. from S. Line

_____ Ft. from E. Line

330 Ft. from W. Line

Elev. 2225

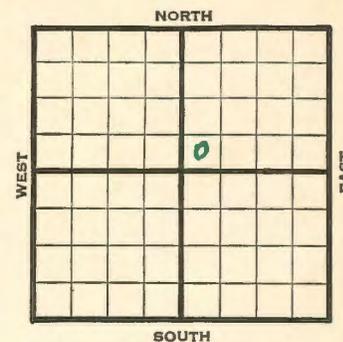

1942		REPORT
5/27	8" - 162'	WOC.
6/3	Drlg. 3630'	
6/10	Lans. 3395' Arb. 3629' Reagan ³⁶⁵⁰ 3648	
	Granite Wash 3705' Granite 3718'	
	T.D. ³⁷²⁷ 3723 5" - ³⁷²⁷ 3723 RUST.	
6/17	Plug 3658-62' 12 shots 3648-52'	
	6 shots 3650-52' 2800' oil 6 hours.	
6/24	Reagan 3650((Corrected)	
	5" - 3727'	
	T.D. 3727'	
	18 shots 3648-52'	
	Depthograph potential 1314 bbls.	
	35. Gravity	
	COMPLETED	

Phillips

KANSAS

Map No. 133 Sec. 29 Twp. 5 R. 20W

Well No. 1 Reese "D"

Cities Service Oil Company
FIRST REPORT
Contractor

SW NE

SECTION PLAT

_____ Ft. from N. Line
330 Ft. from S. Line
_____ Ft. from E. Line
330 Ft. from W. Line

RAY POOL

Location _____
Rig up _____
Drilling and Remarks:

8" - 162'

Waiting on
cement to set

RECORD

Cased _____ in., _____ ft.
Sand _____
Gas _____
Oil _____
Total Depth _____

PRODUCTION

1st 24 hrs. Nat. _____
1st 24 hrs. after shot _____
Gas _____ Cu. Ft.
Dry Hole _____
Abandoned _____

Date

MAY 27 1942 19

S. J. LEWIS Scout

Phillips

KANSAS

Map No. 133 Sec. 29 Twp. 5 R. 20W

Well No. 1 Reese "D"

Cities Service Oil Company
COMPLETED
Contractor

SW NE

SECTION PLAT

_____ Ft. from N. Line
330 Ft. from S. Line
_____ Ft. from E. Line
330 Ft. from W. Line

RAY POOL

Location _____
Rig up _____
Drilling and Remarks:

Reagan 3650 CWB
5-2-3727

18 shots 3648-52.

Depth 1314

35° Gr.

RECORD

Cased _____ in., _____ ft.
Sand _____
Gas _____
Oil _____
Total Depth 3227

PRODUCTION

1st 24 hrs. Nat. _____
1st 24 hrs. after shot _____
Gas _____ Cu. Ft.
Dry Hole _____
Abandoned _____

Date

JUN 24 1942 19

S. J. LEWIS Scout