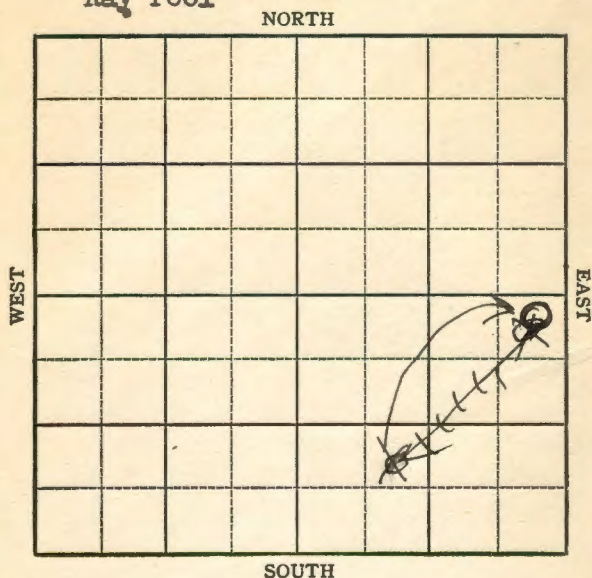
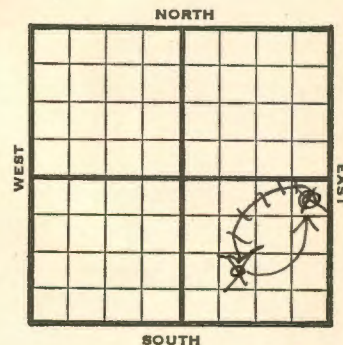


Section 29 Township 5 Range 20WWell No. 4 Wallgren "A"Company Cities Service
Ray Pool

SOUTH

9

Sec. 29 Twp. 5 R. 20WWell No. 4 Wallgren "A" FarmCities Service Company
Ray Pool~~330~~ Ft. from N. Line990' Ft. from S. Line~~330~~ Ft. from E. Line990' Ft. from W. Line~~NE-SE~~ NE-SE~~NE-SW-SE~~1948 **Elev. 2206** REPORT

9/1 8" @ 202'
WOC

9/8 Drlg 2980'

9/14 **Lansing 3367'**
BKC 3567'
Arb. 3612'
Reagan 3625'
TD 3626'
5" @ 3626'
26 shots 3614-22-1000 acid
Pump 69 bbls oil / 60 W 14 hrs.

9/21 Pump 447 bbls oil 24 hrs.

9/29 **Arbuckle 3612'**
Reagan 3625'
TD 3628'
5" @ 3626'
3000 Acid
Echo Pot 1318 oil
Gr. 28°
TD 3628'

COMPLETED

Map No. 133 Sec. 29 Twp. 5 R. 20WWell No. 4 Wallgren "A"

Cities Service

Company

COMPLETE

Contractor

NE SW SE

E1,2206
SECTION PLAT

Ft. from N. Line

990 Ft. from S. Line

Ft. from E. Line

990 Ft. from W. Line

Phillips County

Location

Rig up

Drilling and Remarks:

Per X 3612
Regan 3615
755125
5" 03626

Echro Pa 413152625-42

RECORD

Cased _____ in., _____ ft.

Sand _____

Gas _____

Oil ☒Total Depth 3625

PRODUCTION

1st 24 hrs. Nat. _____

1st 24 hrs. after shot _____

Gas _____ Cu. Ft.

Dry Hole _____

Abandoned _____

Date

SEP 29 1948

19

S. J. LEWIS

Scout

Phillips County Kansas State

Map No. 133 Sec. 29 Twp. 5 R. 20WWell No. 4 Wallgren "A"

Cities Service

Company

CORRECTION

Contractor

NE SW SE

SECTION PLAT

Ft. from N. Line

990 Ft. from S. Line

Ft. from E. Line

990 Ft. from W. Line

Ray Pool

Remarks:

Reported NE SE

Date

SEP 8 1948

Scout

S. J. LEWIS

S. J. LEWIS . Scout