


KANSAS

Phillips


Section 29 Township 5 Range 20W  
 Well No. 3 Wallgren "B"  
 Company Cities Service

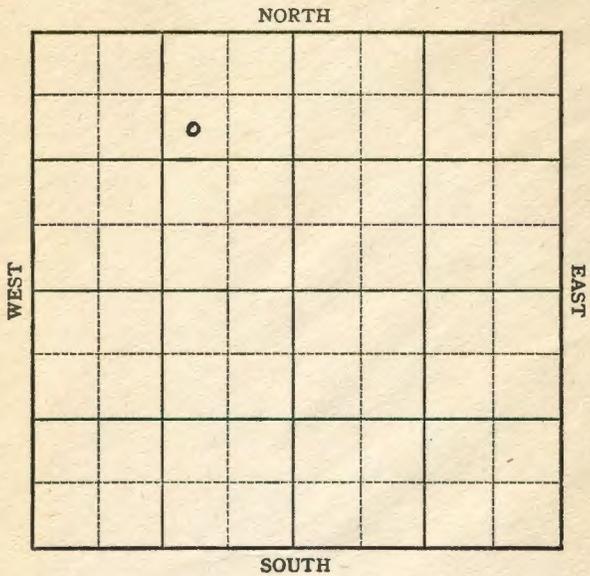

KANSAS

Phillips

Sec. 29 Twp. 5 R. 20-W  
 Well No. #3 Wallgren "B" Farm \_\_\_\_\_  
 Cities Service \_\_\_\_\_  
 Hansen Pool \_\_\_\_\_ Company \_\_\_\_\_  
 990 \_\_\_\_\_ Ft. from N. Line  
 \_\_\_\_\_ Ft. from S. Line  
 990 \_\_\_\_\_ Ft. from E. Line  
 \_\_\_\_\_ Ft. from W. Line

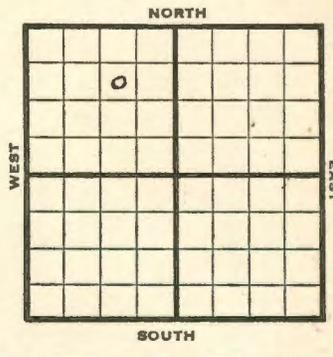

SW NE NW

1947 Elev. 2193' REPORT

- 4/16 RUR
- 4/23 8" @ 198'  
Drlg 3406'
- 4/29 Lansing 3374'  
Arb. 3609'  
TD 3612'  
5" @ 3610'  
RUST
- 5/7 Arb 3606 corrected  
5" @ 3607  
TD 3614'  
1000 Acid  
Pump 93 bbls oil in 24 hrs
- 5/14 Arb. 3606'  
5" @ 3607'  
1000 Acid  
TD 3614'  
Pump 105 POT  
28.0 Gr.

COMPLETED

Map No. K133 Sec. 29 Twp. 5 R. 20W

Well No. 3 Wallgren "B"

Cities Service Company

COMPLETE Contractor

SW NE NW

*E12128*  
SECTION PLAT


990 Ft. from N. Line

\_\_\_\_\_ Ft. from S. Line

990 Ft. from E. Line

\_\_\_\_\_ Ft. from W. Line

Phillips County

Location \_\_\_\_\_

Rig up \_\_\_\_\_

Drilling and Remarks:

*CR 48606*  
*5" @ 3607*  
*1000 @ 3610*  
*Pump 105 Bkt*

*28 3/4*

RECORD

Cased \_\_\_\_\_ in., \_\_\_\_\_ ft.

Sand \_\_\_\_\_

Gas \_\_\_\_\_

Oil \_\_\_\_\_

Total Depth 3614

PRODUCTION

1st 24 hrs. Nat. \_\_\_\_\_

1st 24 hrs. after shot \_\_\_\_\_

Gas \_\_\_\_\_ Cu. Ft.

Dry Hole \_\_\_\_\_

Abandoned \_\_\_\_\_

Date

MAY 14 1947 19

S. J. LEWIS Scout

Map No. K133 Sec. 29 Twp. 5 R. 20W

Well No. 3 Wallgren "B"

Cities Service Company

FIRST REPORT Contractor

SW NE NW

SECTION PLAT


990 Ft. from N. Line

\_\_\_\_\_ Ft. from S. Line

990 Ft. from E. Line

\_\_\_\_\_ Ft. from W. Line

Phillips County

Location \_\_\_\_\_

Rig up \_\_\_\_\_

Drilling and Remarks:

R U R

RECORD

Cased \_\_\_\_\_ in., \_\_\_\_\_ ft.

Sand \_\_\_\_\_

Gas \_\_\_\_\_

Oil \_\_\_\_\_

Total Depth \_\_\_\_\_

PRODUCTION

1st 24 hrs. Nat. \_\_\_\_\_

1st 24 hrs. after shot \_\_\_\_\_

Gas \_\_\_\_\_ Cu. Ft.

Dry Hole \_\_\_\_\_

Abandoned \_\_\_\_\_

Date

APR 16 1947 19

S. J. LEWIS Scout