

KANSAS

Phillips


FORM 51 5M 10-41 PETROL

Section 29 Township 5 Range 20-W

Well No. 5 Pinkerton

Company Cities Service Oil

NORTH Ray Pool

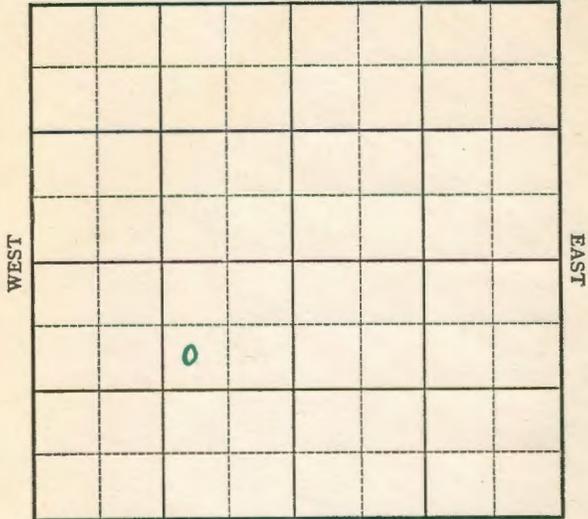

SOUTH

11

FORM 252-A
5M 10-41 PETROL

KANSAS

Phillips

Sec 29 Twp 5 R. 20-W

Well No. #5 Pinkerton Farm _____

Cities Service Oil Company _____

(Ray)


990 Ft. from N. Line

_____ Ft. from S. Line

990 Ft. from E. Line

_____ Ft. from W. Line

Elv. 2233

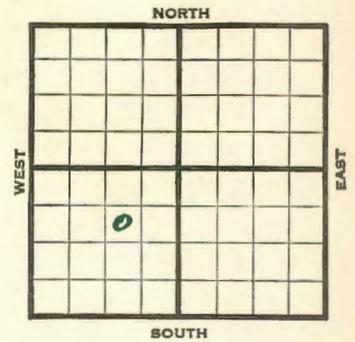

REPORT	
1941	
12/23	Location
12/31	8" - 170' Drlg. 250 7'
1942	
1/8	Arb. 3628' Reagan 3659' B. Reagan 3674' T.D. 3691' 5" - 3691' RUST.
1/15	" " "
1/21	Arb. 3628' 5" - 3691' T.D. 3691' 47 shots 3630-40' Depthograph potential 3005 bbls. Maximum 3000 bbls. 35. Gravity
	COMPLETED

Map No. 133 Sec. 29 Twp. 5 R. 20W

Well No. 5 Pinkerton

Cities Service oil Company

COMPLETED Contractor

SW NE SW

SECTION PLAT

990 Ft. from N. Line

_____ Ft. from S. Line

990 Ft. from E. Line

_____ Ft. from W. Line

RAY POOL

Location _____

Rig up _____

Drilling and Remarks:

Cur 8.3628

5" @ 3691

47 1/2 hrs to 3630-40

Depth to 3000

May 3000

35-0-40

RECORD

Cased _____ in., _____ ft.

Sand _____

Gas _____

Oil _____

Total Depth 3691

PRODUCTION

1st 24 hrs. Nat. _____

1st 24 hrs. after shot _____

Gas _____ Cu. Ft.

Dry Hole _____

Abandoned _____

Date

JAN 21 1942 19

S. J. LEWIS Scout

Map No. 133 Sec. 29 Twp. 5 R. 20W

Well No. 5 Pinkerton

Cities Service Oil Company

FIRST REPORT Contractor

SW NE SW

SECTION PLAT

990 Ft. from N. Line

_____ Ft. from S. Line

990 Ft. from E. Line

_____ Ft. from W. Line

RAY POOL

Location XX

Rig up _____

Drilling and Remarks:

RECORD

Cased _____ in., _____ ft.

Sand _____

Gas _____

Oil _____

Total Depth _____

PRODUCTION

1st 24 hrs. Nat. _____

1st 24 hrs. after shot _____

Gas _____ Cu. Ft.

Dry Hole _____

Abandoned _____

Date

DEC 23 1941 19

S. J. LEWIS Scout