


Section 29 Township 5 Range 20W
Well No. #6 Wallgren "B"
Company Rine Drlg.


Ray Pool

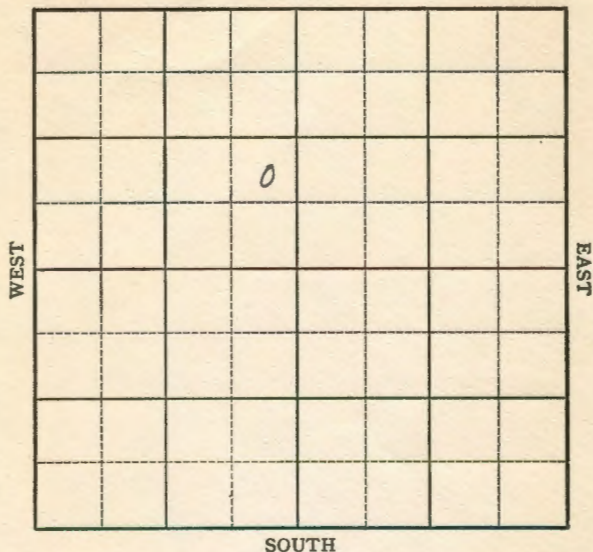

6

Sec. 29 Twp. 5 R. 20W
Well No. #6 Wallgren "B"
Cities Service
Ray Pool (Rine Drlg., Contr.)

_____ Ft. from N. Line
990' Ft. from S. Line
330' Ft. from E. Line
_____ Ft. from W. Line
NE SE NW

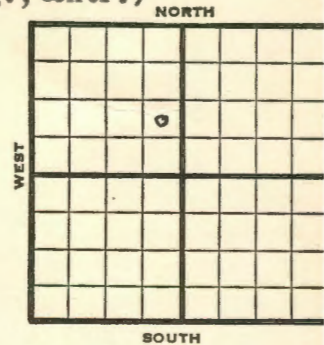

1949

Elev. 2190' REPORT

12/14 Location
 12/21 8" @ 206'
 Drlg 1045'
 12/28 Drlg 3244'

 3/1 8" @ 206'
 5" @ 3622'
 Lans 3363'
 BKC 3557'
 Lm 3622-24
 50 BOPD, 80% wtr
 TD 3624'

COMPLETED

Map No. _____ Sec. 29 Twp. 5 R. 20W

Well No. 6 Wallgren "B"

Cities Service _____ Company

Rine Drlg. _____ Contractor

NE SE NW

FIRST REPORT
SECTION PLAT

_____ Ft. from N. Line

990 Ft. from S. Line

330 Ft. from E. Line

_____ Ft. from W. Line

	o		

Phillips County

Location _____ X

Rig up _____

Drilling and Remarks:

RECORD

Cased _____ in., _____ ft.

Sand _____

Gas _____

Oil _____

Total Depth _____

PRODUCTION

1st 24 hrs. Nat. _____

1st 24 hrs. after shot _____

Gas _____ Cu. Ft.

Dry Hole _____

Abandoned _____

Date

DEC 14 1949 19

S. J. LEWIS Scout

Map No. _____ Sec. 29 Twp. 5 R. 20W

Well No. 6 Wallgren "B"

Cities Service _____ Company

Contractor

NE SE NW

El. 2190
SECTION PLAT

_____ Ft. from N. Line

990 Ft. from S. Line

330 Ft. from E. Line

_____ Ft. from W. Line

	o		
COMPLETE			

Phillips County

Location _____

Rig up _____

Drilling and Remarks:

8" @ 206

5" @ 3622

Law 3363

BXC 3557

Am 3622-24

50 BOPD:

80% water.

Date

MAR 1 1950 19

RECORD

Cased _____ in., _____ ft.

Sand _____

Gas _____

Oil _____

Total Depth 3624

PRODUCTION

1st 24 hrs. Nat. _____

1st 24 hrs. after shot _____

Gas _____ Cu. Ft.

Dry Hole _____

Abandoned _____

J. E. TYRA Scout