


Section 30 Township 5 Range 20W

Well No. #4 Bailey

Company Cities Service

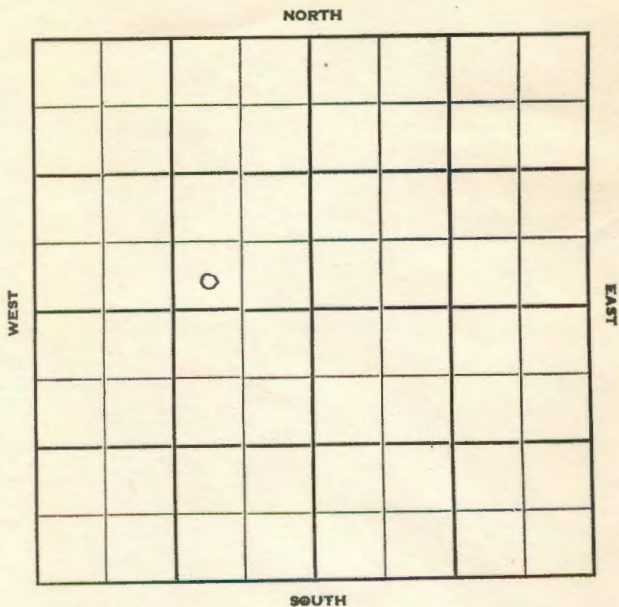

FORM 252-B
10M 11-50 PETROL Phillips **KANSAS**


Sec. 30 Twp. 5 R. 20 W

Well No. #4 Bailey Farm

Cities Service Company

Ray Pool Contractor

Ft. from N. Line
330 Ft. from S. Line
990 Ft. from E. Line
Ft. from W. Line
SW SE NW

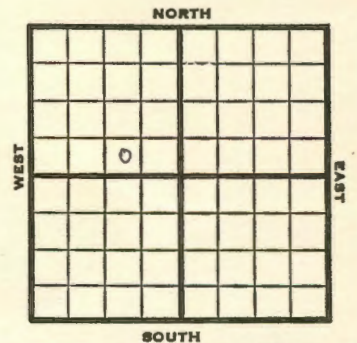

1951 **Elev. 2225'** REPORT

9/12 Location
11/21 Spud 9-13-51
Oil well TD 3653'
8" @ 200' Dodge 3303' Lans. 3331'
Arb. 3650-53 Regan 3563'
5" @ 3651' TD 3653'
P/35 BO 42 BW 18 hrs.
Comp. 56 BOPD 54% water

COMPLETED

County	Phillips			State	Kansas
Sec.	30	(Blk. Twp.)	5	(Sur. Rge.)	20W
					Map No.

Operator Cities Service

Well No. 4 Farm Bailey

Elev.	2225	Location	SW SE NW
-------	------	----------	----------

330 Ft. From S Line NW

990 Ft. From E Line Quarter

1st. Report

Completion NOV 21 1951

Remarks	Ray Pool
---------	----------

Spudding Date 9-13-51

Drig. Data Oil well TD 3653

8" @ 200 Dodge 3303 Lans. 3331

Arb. 3650-53 Regan 3563 5" @ 3651

TD 3653 P/ 35 bo 42 bw 18 hr.

Comp. 56 bopd 54% water

J. E. TYRA

County	Phillips			State	Kansas
Sec.	30	(Blk. Twp.)	5	(Sur. Rge.)	20W
					Map No.

Operator **Cities Service**

Well No. 4 Farm Bailey

Elev.	Location	SW	SE	NW
-------	----------	----	----	----

0

FIRST REPORT

530 Ft. From 8 Line NW

990 Ft. From E Line Quarter

1st. Report SEP 12 1951

Completion

Remarks

Spudding Date

Drbg. Data

Ray Pool

Location

J. E. TYRA