

KANSAS


Phillips

FORM 51 5M 10-41 PETROL

Section 30 Township 5 Range 20-WWell No. #3 StatesCompany Cities Service Oil

Ray Pool

NORTH

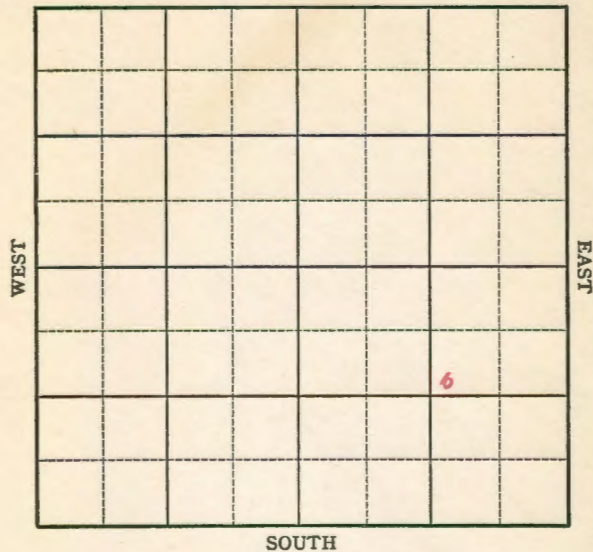

SOUTH

9

Form 252-A
5M 5-42 Petrol

KANSAS Phillips

Sec. 30 Twp. 5 R. 20-WWell No. #3 States Farm

Cities Service Oil Company

(Ray Pool)


990 Ft. from N. Line

Ft. from S. Line

990 Ft. from E. Line

Ft. from W. Line

Elev. 2232

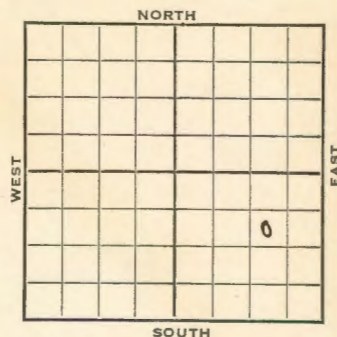

1942

REPORT

9/16 10" - 150'
Drlg. 22809/23 Lansing 3386
Arb. 3637
Reagan 3646
T. D. 3650
7" 3644 Rust9/30 TD 3652 water 3650-52
Perf. 3645-50

10/7 1000 acid testing

10/14 Pump 8 oil per hr 6 hrs SD.

10/21 " " " " " " " "

10/28 Reagan 3646
7" - 3644'
Arb. 3637'
22 shots 3645-50
1000 acid
T.D. 3650'
Pump 85 Pot.
Gravity 35.

COMPLETED

Map No. 133 Sec. 30 Twp. 5 R. 20WWell No. 3 States

Cities Service Oil Company

COMPLETED Contractor

SW NE SE

SECTION PLAT

990 Ft. from N. Line

Ft. from S. Line

990 Ft. from E. Line

Ft. from W. Line

Ray Pool

Location

Rig up

Drilling and Remarks:

*Reagan 3646**7" @ 3644**Cu 3637**22 shots 3645-50**1000 acid**Pump 5528**35° 92'*

RECORD

Cased in. ft.

Sand

Gas

Oil

Total Depth *3650*

PRODUCTION

1st 24 hrs. Nat.

1st 24 hrs. after shot

Gas Cu. Ft.

Dry Hole

Abandoned

Date

OCT 28 1942

19

S. J. LEWIS Scout

KANSAS

Map No. 133 Sec. 30 Twp. 5 R. 20WWell No. 3 States

Cities Service Oil Company

FIRST REPORT Contractor

SW NE SE

SECTION PLAT

990 Ft. from N. Line

Ft. from S. Line

990 Ft. from E. Line

Ft. from W. Line

RAY POOL

Location

Rig up

Drilling and Remarks:

10" - 150'

Drlg. 2280'

RECORD

Cased in. ft.

Sand

Gas

Oil

Total Depth

PRODUCTION

1st 24 hrs. Nat.

1st 24 hrs. after shot

Gas Cu. Ft.

Dry Hole

Abandoned

Date

SEP 16 1942

19

S. J. LEWIS Scout