


Section 30 Township 5 Range 20-W

Well No. #4 States "A"

Company Cities Service

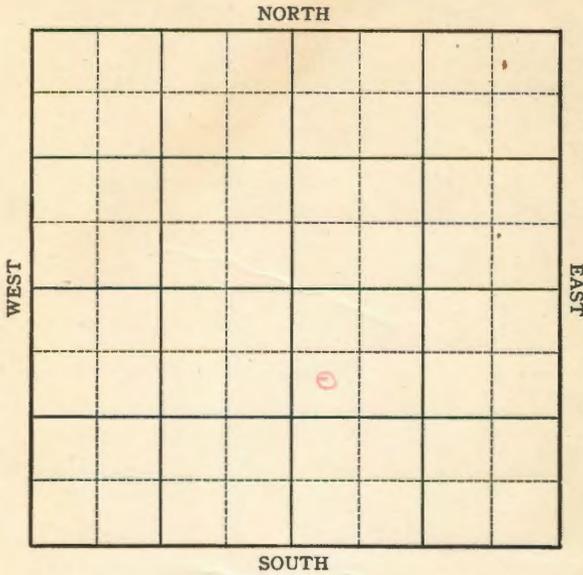

10

Sec. 30 Twp. 5 R. 20W

Well No. #4 States "A" Farm \_\_\_\_\_

Cities Service Company \_\_\_\_\_

Hansen


990 Ft. from N. Line

\_\_\_\_\_ Ft. from S. Line

\_\_\_\_\_ Ft. from E. Line

330 Ft. from W. Line

SW NW SE

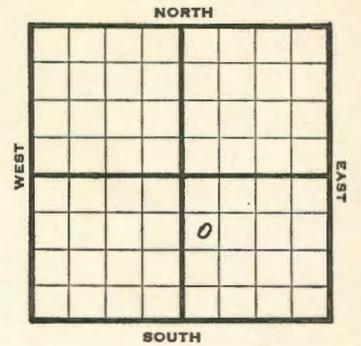

1946 **Elev. 2230'** REPORT

- 8/14 Location
- 8/20 8" @ 198  
Drlg 2800'
- 8/27 Reagan 3650  
TD 3652  
5" @ 3651'
- 9/5 Dans 3407  
BKC 3605  
Pump 316 oil 241 WOC
- 9/11 Reagan 3650'  
5" @ 3650'  
Pump 377 Pot  
TD 3652'  
Grav 28.4

**COMPLETED**

KANSAS Pool Name Hansen Pool

Map No. 133 Sec. 30 Twp. 5 R. 20W

Well No. 4 States "A"

Cities Service Company

COMPLETED

Contractor

SW NW SE

E1.2280  
SECTION PLAT

990 Ft. from N. Line

\_\_\_\_\_ Ft. from S. Line

\_\_\_\_\_ Ft. from E. Line

330 Ft. from W. Line


Phillips County

Location \_\_\_\_\_

Rig up \_\_\_\_\_

Drilling and Remarks:

*Reagan 3650*  
*5" 3650*  
*Pump 377 Pst*

RECORD

Cased \_\_\_\_\_ in. \_\_\_\_\_ ft.

Sand \_\_\_\_\_

Gas \_\_\_\_\_

Oil \_\_\_\_\_

Total Depth 3650

PRODUCTION

1st 24 hrs. Nat. \_\_\_\_\_

1st 24 hrs. after shot \_\_\_\_\_

Gas \_\_\_\_\_ Cu. Ft.

Dry Hole \_\_\_\_\_

Abandoned \_\_\_\_\_

Date

SEP 1 1 1946 19 S. J. LEWIS Scout

*284*

KANSAS Kansas Pool Name Hansen

Map No. 133 Sec. 30 Twp. 5 R. 20W

Well No. 4 States "A"

Cities Service Company

FIRST REPORT

Contractor

SW NW SE

SECTION PLAT

990 Ft. from N. Line

\_\_\_\_\_ Ft. from S. Line

\_\_\_\_\_ Ft. from E. Line

330 Ft. from W. Line


Phillips County

Location X \_\_\_\_\_

Rig up \_\_\_\_\_

Drilling and Remarks:

RECORD

Cased \_\_\_\_\_ in. \_\_\_\_\_ ft.

Sand \_\_\_\_\_

Gas \_\_\_\_\_

Oil \_\_\_\_\_

Total Depth \_\_\_\_\_

PRODUCTION

1st 24 hrs. Nat. \_\_\_\_\_

1st 24 hrs. after shot \_\_\_\_\_

Gas \_\_\_\_\_ Cu. Ft.

Dry Hole \_\_\_\_\_

Abandoned \_\_\_\_\_

Date

AUG 1 4 1946 19 S. J. LEWIS Scout