


KANSASSection 30 Township 5 Range 20WWell No. 5 States "A"Company Cities Service

Ray Pool

NORTH

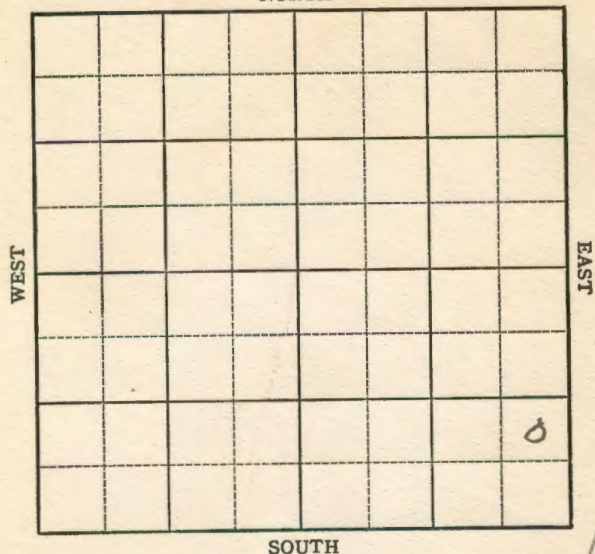

SOUTH

16

Sec. 30 Twp. 5 R. 20W ✓Well No. #5 States "A" Farm

Cities Service Company

Ray Pool


Ft. from N. Line

990' Ft. from S. Line

330' Ft. from E. Line

Ft. from W. Line

NE SE SE

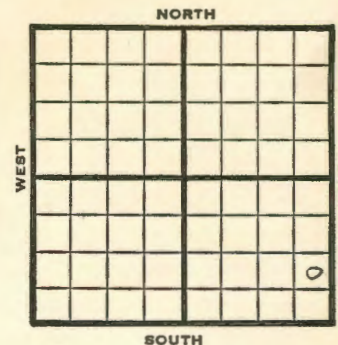

1949 Elev 2218' REPORT

3/16 8" @ 221'
 3/23 Drlg. 3620'
 3/29 L ansing 3380'
 BKG 3582'
 Arb. 3616'
 Reagan 3625'-70'
 TD 3670'
 5"@ 3670'
 4/6 "
 4/12 "
 4/20 10 shots 3642-44
 420' oil / 300' W Squeeze
 4/27 "
 5/4 Plug 3631-34 shots 3624-32
 Pump 233 bbls oil / 8% W 24 hrs
 TD 3670'
 Reagan 3625'
 5"@ 3670'
 Perf
 Pump 383 oil / 1% W Pot
 30° Gr.
 Comp

COMPLETED

Map No. K133 Sec. 30 Twp. 5 R. 20WWell No. 5 States "A"

Cities Service

Company

COMPLETE

Contractor

NE SE SE

SECTION PLAT

Ft. from N. Line

990

Ft. from S. Line

330

Ft. from E. Line

Ft. from W. Line

Phillips County

Location

Rig up

Drilling and Remarks:

Reagan 3625
5-05670
Ray.
Phy. 373 oil 7
17.4W Port

3000

Date

MAY 11 1949 19

S. J. LEWIS

Scout

RECORD

Cased in, ft.

Sand

Gas

Oil

Total Depth 3670

PRODUCTION

1st 24 hrs. Nat.

1st 24 hrs. after shot

Gas Cu. Ft.

Dry Hole

Abandoned

Map No. Sec. 3 Twp. 5 R. 20WWell No. 5 States "A"

Cities Service

Company

FIRST REPORT

Contractor

NE SE SE

SECTION PLAT

Ft. from N. Line

990

Ft. from S. Line

330

Ft. from E. Line

Ft. from W. Line

Phillips County

Location

Rig up

Drilling and Remarks:

8" @ 221

Date

MAR 16 1949 19

S. J. LEWIS

Scout

RECORD

Cased in, ft.

Sand

Gas

Oil

Total Depth

PRODUCTION

1st 24 hrs. Nat.

1st 24 hrs. after shot

Gas Cu. Ft.

Dry Hole

Abandoned

Map No. _____ Sec. 30 Twp. 5 R. 20W

Well No. 5 States "A"

Cities Service _____ Company

CORRECTION _____ Contractor

NE SE SE

SECTION PLAT

_____ Ft. from N. Line

990 Ft. from S. Line

330 Ft. from E. Line

_____ Ft. from W. Line

Phillips County

Location _____

Rig up _____

Drilling and Remarks:

Reported

3-5-20W

RECORD

Cased _____ in., _____ ft.

Sand _____

Gas _____

Oil _____

Total Depth _____

PRODUCTION

1st 24 hrs. Nat. _____

1st 24 hrs. after shot _____

Gas _____ Cu. Ft.

Dry Hole _____

Abandoned _____

Date

MAR 23 1949 19

S. J. LEWIS Scout