


Section 30 Township 5 Range 20-W

Well No. #7 States "A"

Company Cities Service
Ray Pool

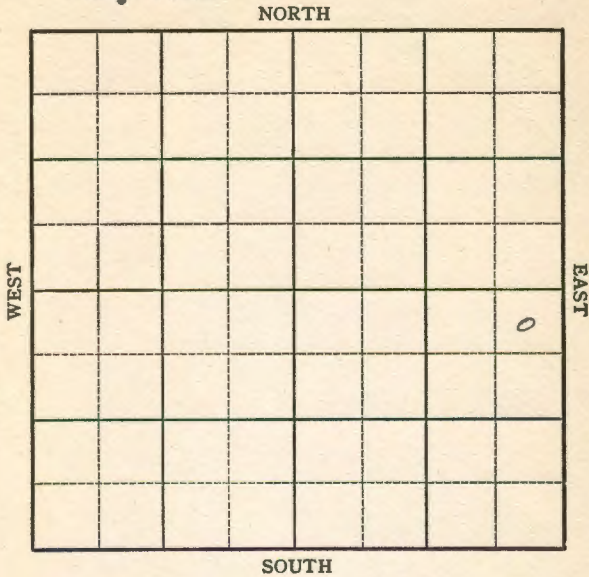

9

Sec. 30 Twp. 5 R. 20W

Well No. #7 States "A"

Cities Service


Ray Pool Rine Drlg., Contr.

330' Ft. from N. Line

_____ Ft. from S. Line

330' Ft. from E. Line

_____ Ft. from W. Line

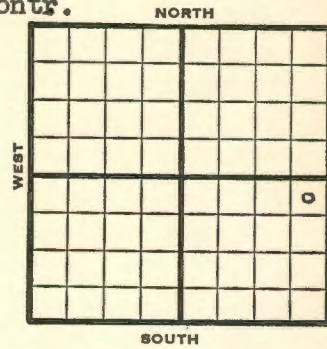

NE SE

1949 **Elev 2229'** REPORT

11/16 8" @ 205'
 11/23 Drlg 3595'
 11/29 **Lansing 3403'**
Reagan 3647'-51'
 TD 3651'
 5" @ 3649'
 Pump 212 bbls oil 14 hrs.
12/7 TD 3651'
Reagan 3647'
 5" @ 3649'
 Pump 776 Oil Pot
 35° Gr.
 Comp

COMPLETED

Map No. _____ Sec. 30 Twp. 5 R. 20W

Well No. 7 States "A"

Cities Service _____ Company

Rine Drlg. _____ Contractor

NE SE

FIRST REPORT
SECTION PLAT

330 Ft. from N. Line

_____ Ft. from S. Line

330 Ft. from E. Line

_____ Ft. from W. Line

| | | | |
|--|--|--|---|
| | | | |
| | | | |
| | | | o |
| | | | |

Phillips County

Location _____

Rig up _____

Drilling and Remarks:

8" @ 205

RECORD

Cased _____ in., _____ ft.

Sand _____

Gas _____

Oil _____

Total Depth _____

PRODUCTION

1st 24 hrs. Nat. _____

1st 24 hrs. after shot _____

Gas _____ Cu. Ft.

Dry Hole _____

Abandoned _____

Date

NOV 16 1949

19

S. J. LEWIS

Scout

Map No. _____ Sec. 30 Twp. 5 R. 20W

Well No. 7 States "A"

Cities Service _____ Company

COMPLETE

Contractor

NE SE

E13229
SECTION PLAT

330 Ft. from N. Line

_____ Ft. from S. Line

330 Ft. from E. Line

_____ Ft. from W. Line

| | | | |
|--|--|--|---|
| | | | |
| | | | |
| | | | o |
| | | | |

Phillips County

Location _____

Rig up _____

Drilling and Remarks:

Reagan 3647

5" @ 3647

Only 77 bails

RECORD

Cased _____ in., _____ ft.

Sand _____

Gas _____

Oil _____

Total Depth *365'*

PRODUCTION

1st 24 hrs. Nat. _____

1st 24 hrs. after shot _____

Gas _____ Cu. Ft.

Dry Hole _____

Abandoned _____

Date

DEC 7 1949

19

S. J. LEWIS

Scout