

KANSAS


Section 31 Township 5 Range 20W

Well No. 16 Pinkerton

Company Cities Service

Ray Pool

NORTH

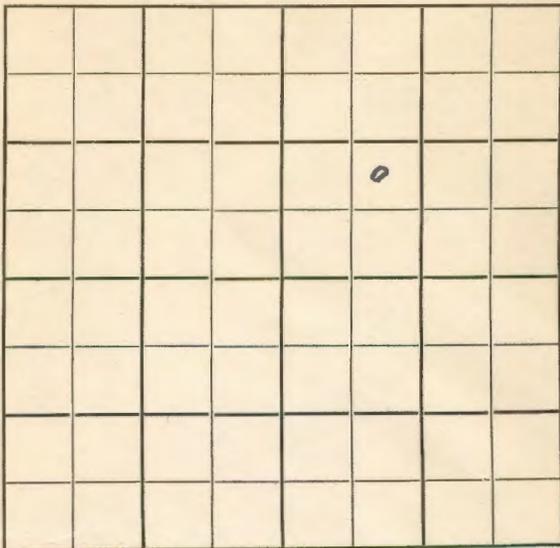

SOUTH

7

KANSAS

Sec. 31 Twp. 5 R. 20W

Well No. #16 Pinkerton Farm _____

Cities Service

Company

Ray Pool (Rine Drlg., Cont.) NORTH


_____ Ft. from N. Line

990' Ft. from S. Line

_____ Ft. from E. Line

990' Ft. from W. Line

NE SW NE

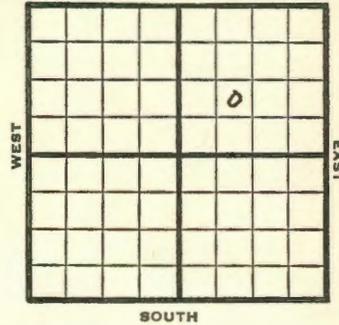

1949 **Elev. 2216'** REPORT

8/31 Location
 9/7 RUR
 9/14 8" @ 196'
 Drlg 2642'

9/21 **Lansing 3387'** **BKC 3583'**
Reagan 3623' **Schist 3651'**
Quartzite 3661'
 TD 3662'

9/28 5" @ 3662'
 59 shots 3640-43
 Pump 105 bbls oil 14 hrs.

10/5 " "
 10/12 " "
 10/19 " "

10/26 **Reagan 3623'**
Quartzite 3661'
 5" @ 3662'
 Perf Reagan
 Pump 182 oil Pot.
 Gr. 35
 TD 3662'

COMPLETED

Kansas

Map No. _____ Sec. 31 Twp. 5 R. 20W

Well No. 16 Pinkerton

Cities Service Company
COMPLETE

Contractor

NE SW NE

EI. 2216
SECTION PLAT

_____ Ft. from N. Line
990 Ft. from S. Line
_____ Ft. from E. Line
990 Ft. from W. Line

Phillips County

Location _____

Rig up _____

Drilling and Remarks:

Reagan 3663
Quadrant 4661
5" 3662
Prof Reagan
Prof 182 oil Prod.
80-25

RECORD

Cased _____ in., _____ ft.
Sand _____
Gas _____
Oil _____
Total Depth *3662*

PRODUCTION

1st 24 hrs. Nat. _____
1st 24 hrs. after shot _____
Gas _____ Cu. Ft.
Dry Hole _____
Abandoned _____

Date

OCT 26 1949 19 S. J. LEWIS Scout

Kansas

Map No. _____ Sec. 31 Twp. 5 R. 20W

Well No. 16 Pinkerton

Cities Service Company

Rine Drlg. Contractor

NE SW NE

FIRST REPORT
SECTION PLAT

_____ Ft. from N. Line
990 Ft. from S. Line
_____ Ft. from E. Line
990 Ft. from W. Line

Phillips County

Location _____

Rig up _____

Drilling and Remarks:

X

RECORD

Cased _____ in., _____ ft.
Sand _____
Gas _____
Oil _____
Total Depth _____

PRODUCTION

1st 24 hrs. Nat. _____
1st 24 hrs. after shot _____
Gas _____ Cu. Ft.
Dry Hole _____
Abandoned _____

Date

AUG 31 1949 19 S. J. LEWIS Scout