


KANSAS

Section 30 Township 5 Range 20-W

Well No. #4, States "B"

Company Cities Service Oil Company

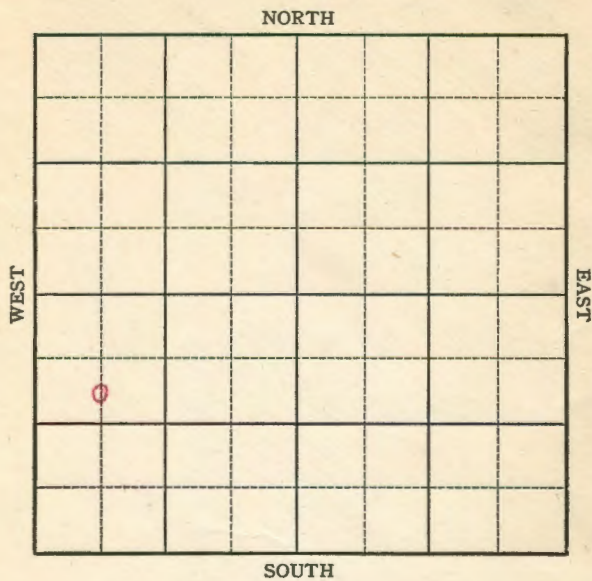

12

Sec. 30 Twp. 5 R. 20W

Well No. #4 States "B" Farm

Cities Service Company

Hansen


990 Ft. from N. Line

_____ Ft. from S. Line

_____ Ft. from E. Line

660 Ft. from W. Line

C S L NW SW

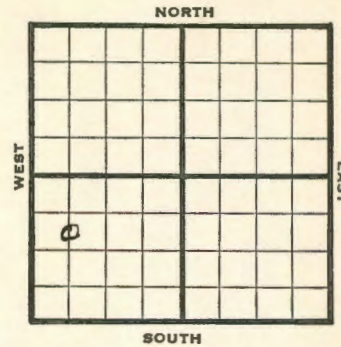

1946	Elev. 2250' REPORT
10/16	RUR
10/22	8" @ 200' Drlg 2575'
10/29	Lans 3441' Reagan 3674' TD 3676 5" @ 3675, RUST
11/6	TD 3678' Pump 125 oil in 24 hrs.
11/13	Reagan 2674' 5" @ 3675' Pump 140 POT TD 3678' 28 Grav.
	COMPLETED

Map No. 133 Sec. 30 Twp. 5 R. 20W

Well No. 4 States "B"

Cities Service _____ Company

COMPLETED

Contractor

C S L NW SW

E1,2258
SECTION PLAT

990 Ft. from N. Line

_____ Ft. from S. Line

_____ Ft. from E. Line

660 Ft. from W. Line

Phillips County

Location _____

Rig up _____

Drilling and Remarks: *11*

Reagan 3674
5 @ 3675
Pump 140 BT

RECORD

Cased _____ in., _____ ft.

Sand _____

Gas _____

Oil _____

Total Depth 3677

PRODUCTION

1st 24 hrs. Nat. _____

1st 24 hrs. after shot _____

Gas _____ Cu. Ft.

Dry Hole _____

Abandoned _____

Date

NOV 13 1946 19

S. J. LEWIS Scout

Map No. 133 Sec. 30 Twp. 5 R. 20W

Well No. 4 States "B"

Cities Service _____ Company

FIRST REPORT

Contractor

C S L NW SW

SECTION PLAT

990 Ft. from N. Line

_____ Ft. from S. Line

_____ Ft. from E. Line

660 Ft. from W. Line

Phillips County

Location _____

Rig up _____

Drilling and Remarks:

R U R

RECORD

Cased _____ in., _____ ft.

Sand _____

Gas _____

Oil _____

Total Depth _____

PRODUCTION

1st 24 hrs. Nat. _____

1st 24 hrs. after shot _____

Gas _____ Cu. Ft.

Dry Hole _____

Abandoned _____

Date

OCT 16 1946 19

S. J. LEWIS Scout