


Section 30 Township 5 Range 20W
Well No. #7 States "B"
Company Cities Service

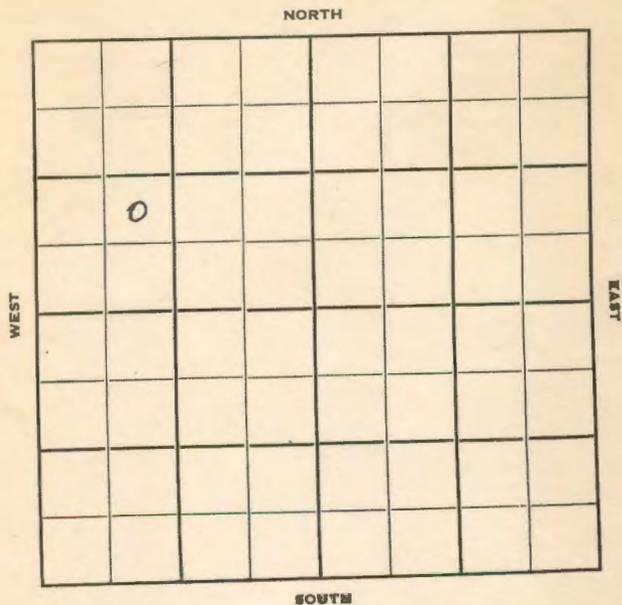

Sec. 30 Twp. 5 R. 20W
Well No. #7 States "B" Farm

Cities Service Company

Rine Drlg. Contractor

Ray Pool


_____ Ft. from N. Line

990' Ft. from S. Line

_____ Ft. from E. Line

990' Ft. from W. Line

NE SW NW

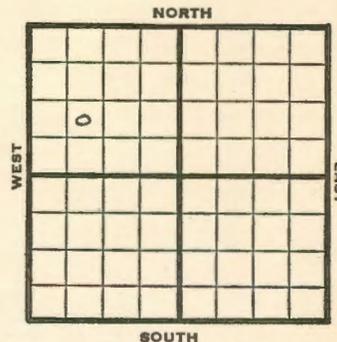

1950 **Elev. 2211'** REPORT

9/27 Location
 11/22 Spud 10-4-50
 Oil Well TD 3654'
 DST 3641-52 opn 1/2 hr.
 Rec. 870' oil 30' ocm
 5" @ 3648'
 DD 3654
 FU 1255' oil 1200' wtr in 8 hr
 PB 3641 P/224 bo 68 bw 23 hr.
 Comp. 290 bopd 5% wtr.

COMPLETED

County Phillips State Kansas
 Sec. 30 (Blk. 5 (Sur. 20W Map No.
 Operator Cities Service
 Well No. 7 Farm States "B"
 Elev. 2211 Location NE SW NW

990 Ft. From S Line NW
990 Ft. From W Line Quarter
 Ist. Report _____
 Completion NOV 22 1950
 Remarks Ray Pool
Rine Drlg. - Contr.
 Spudding Date 10-4-50

Drlg. Data Oil well TD 3654
8" @ 198 Regan 3647 TD 3652
DST 3641-52 open $\frac{1}{2}$ hr. Rec. 870' oil
30' ocm 5" @ 3648 DD 3654 FU 1255' oil
1200' water in 8 hr. PB 3651 P/ 224 bo
68 bw 23 hr.
 Comp. 2.90 hopd 5% water

J. E. TYRA

County Phillips State Kansas
 Sec. 30 (Blk. 5 (Sur. 20W Map No.
 Operator Cities Service
 Well No. 7 Farm States "B"
 Elev. 2211 Location NE SW NW

990 Ft. From S Line NW
990 Ft. From W Line Quarter
 Ist. Report SEP 27 1950
 Completion _____
 Remarks _____
Rine Drlg. - Contr.
 Spudding Date _____

Drlg. Data Ray Pool
Location

J. E. TYRA