


KANSAS

Section 30 Township 5 Range 20 W

Well No. # 8 States (B)

Company Cities Service Oil

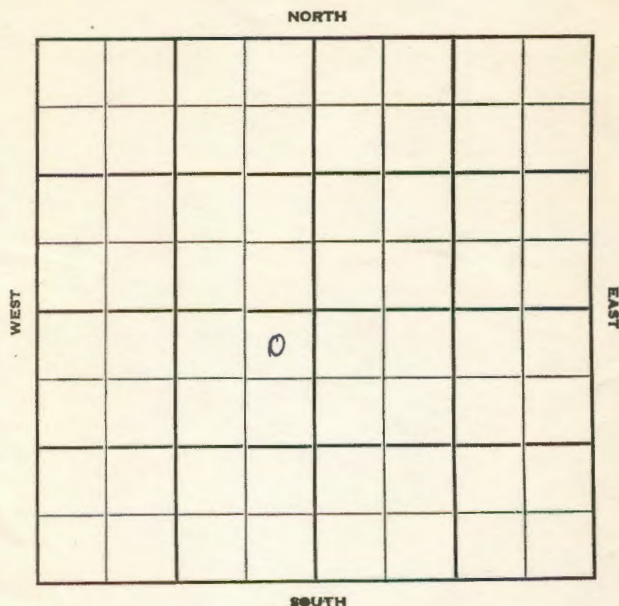

11

Phillips

KANSAS

Sec. 30 Twp. 5 R. 20W

Well No. #8 States (B) Farm _____

Cities Service Oil Co. _____ Company

Rine - Contr. _____ Contractor


330' Ft. from N. Line

Ft. from S. Line

330' Ft. from E. Line

Ft. from W. Line

NE NE SW

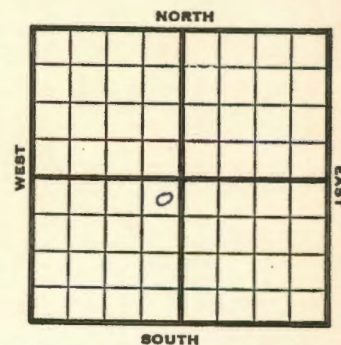

1951 Elev. 2197' REPORT

7/11 Spud 7-2-51
8" @ 200
Drlg. 3434'

8/22 Spud 7-2-51
Oil well TD 3626' 8" @ 200
Heeb 3340' Dodge 3360' Lans. 3377'
Arb. 3613'
TD 3619' 5" @ 3616' DD 3624'
SSO Regan 3624' DD 3626'
FU 2467' oil 14 hr.
P/152 BO 12 BWPD
Comp. 232 BOPD

COMPLETED

County **Phillips** State **Kansas**
 Sec. **30** (Blk. **5** (Sur. **20W** Map No.
 Operator **Cities Service Oil**
 Well No. **8** Farm **States "B"**
 Elev. **2197** Location **NE NE SW**

330 Ft. From **N** Line **SW**
 330 Ft. From **E** Line **Quarter**
 Ist. Report
 Completion **AUG 22 1951**
 Remarks
Rine Drlg. - Contr.
 Spudding Date **7-2-51**

Drig. Data **Oil well TD 3626**
8" @ 200 Heeb. 3340 Dodge 3360
Lens. 3377 Arb. 3613 TD 3619 5" @ 3616
DD 3624 SSO Regan 3624 DD 3626
FU 2467' oil 14 hr. P/ 152 bo 12 bwpd
Comp. 232 bopd

J. E. TYRA

County **Phillips** State **Kansas**
 Sec. **30** (Blk. **5** (Sur. **20W** Map No.
 Operator **Cities Service Oil Co.**
 Well No. **8** Farm **States (B)**
 Elev. **2197** Location **NE NE SW**

330 Ft. From **N** Line **SW**
 330 Ft. From **E** Line **Quarter**
 Ist. Report **JUL 11 1951**
 Completion
 Remarks
Rine - Contr.
 Spudding Date **7-2-51**

Drig. Data
8" @ 200' Drlg. 3434

J. E. TYRA