


Section 31 Township 5 Range 20-W

Well No. 6 Johnson "B"

Company Cities Service Oil

NORTH Ray Pool

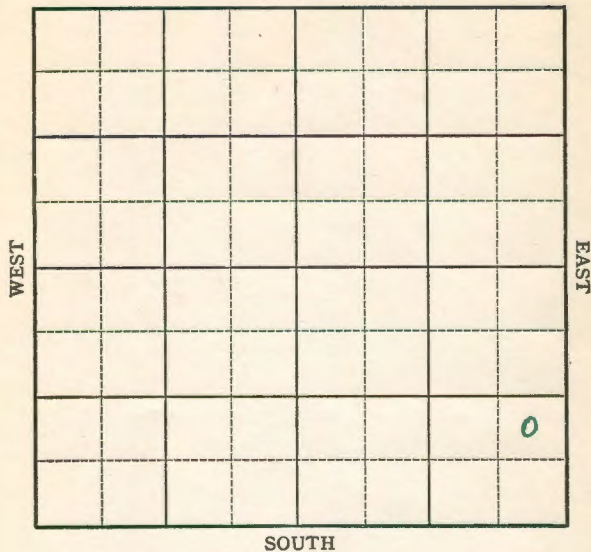

16

Sec. 31 Twp. 5 R. 20-W

Well No. #6 Johnson "B" Farm

Cities Service Oil _____ Company

(Ray)


_Ft. from N. Line

990 _____ Ft. from S. Line

330 Ft. from E. Line

Ft. from W. Line

Edw. 2145

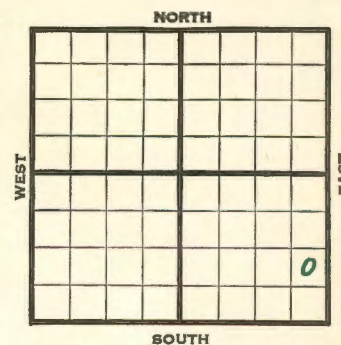

REPORT

1941

12/23	Location
-------	----------

1942

1/8

1/15	10" - 160' WOC.
------	-----------------

1/22 Drlg. 3006

1/28

Granite 3590'

T.D. 3592

No Arbuckle or Reagan.

ABANDONED

Map No. 33 Sec. 31 Twp. 5 R. 20WWell No. 6 Johnson "B"Cities Service Oil CompanyABANDONED Contractor

SECTION PLAT

NE SE SE

_____ Ft. from N. Line

990 Ft. from S. Line330 Ft. from E. Line

_____ Ft. from W. Line

RAY POOL

Location _____

Rig up _____

Drilling and Remarks:

RECORD

Cased _____ in., _____ ft.

Sand _____

Gas _____

Oil _____

Total Depth 3591

PRODUCTION

1st 24 hrs. Nat. _____

1st 24 hrs. after shot _____

Gas _____ Cu. Ft.

Dry Hole _____

Abandoned _____

Date

JAN 28 1942 19 S. J. LEWIS ScoutPhillips **KANSAS**Map No. 33 Sec. 31 Twp. 5 R. 20WWell No. 6 Johnson "B"Cities Service Oil CompanyFIRST REPORT Contractor

SECTION PLAT

NE SE SE

_____ Ft. from N. Line

990 Ft. from S. Line330 Ft. from E. Line

_____ Ft. from W. Line

RAY POOL

Location XX

Rig up _____

Drilling and Remarks:

RECORD

Cased _____ in., _____ ft.

Sand _____

Gas _____

Oil _____

Total Depth _____

PRODUCTION

1st 24 hrs. Nat. _____

1st 24 hrs. after shot _____

Gas _____ Cu. Ft.

Dry Hole _____

Abandoned _____

Date

DEC 23 1941 19 S. J. LEWIS Scout